

3 13P

NESHoba CODED

MISSISSIPPI
BOARD OF WATER COMMISSIONERS

416 North State Street
Jackson, Mississippi 39201

WATER WELL DRILLERS LOG

4-1
date well completed

19 68 OGLETREE DRILLING CO.
firm name

NESHoba
county well located

LANDOWNER: BILL HESTER

description of formations
encountered

from

to

RT. 3

UNION, MISS.

(mailing address)

RED CLAY

0 10

RED SAND

10 50

BLUE CHALK

50 100

RED AND WHITE SAND

100 210

WELL LOCATION:

sec. 9 T 9 N R 13 E
S W

_____ miles _____ of _____
(distance) (direction) (nearest town)

WELL PURPOSE: HOME AND INDUSTRIAL
(home, irrigation, municipal, industrial)

WELL COMPLETION DATA:

CODED

(1) diameter (inches) 4"

(2) total depth (feet) 210

(3) static water level (feet) 70 below
top of ground.

(4) casing STEEL 126
(material) (depth)

4x2 if telescope see back.
(size)

(5) screen 10 210-200
(length) (depth to top)

2" STAINLESS STEEL
(size) (material)

(6) pump 3/4 21.5
(HP) (yield gpm)

REA
(type power)

(7) electric log _____
(yes or no)

(organization running log)

(8) how well bottom plugged POINTED

DRILLERS REMARKS:

MAY 20 1968
MISS. Bd. of
WATER COM.


If well telescopes please sketch and show depths.

GROUND LEVEL

↑
126 ft. 4" casing

↑
2" casing 74 ft

↑
110 ft galvanized SS pipe

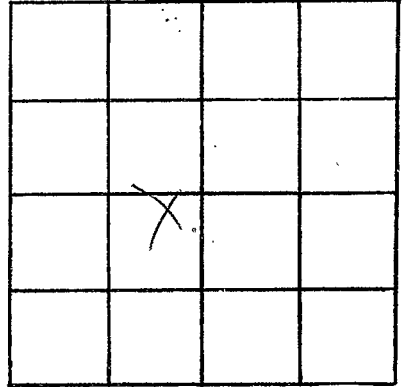

SECTION _____

Please indicate well location X.

ADDITIONAL INFORMATION

If more than one screen, show locations of each on sketch.