

Neshoba
Q 3
9-66

MISSISSIPPI BOARD OF WATER COMMISSIONERS

3 13P

WATER WELL DRILLERS LOG

Date: 9-20, 1966, Driller: B B Nicholson County Neshoba
(Name)

(1) Owner of Land: W E DODD Clayton
Little Rock
(Name)
(Address)

(2) Location: 1/4, 1/4, Sec. 27 T 9 R 13S
2 miles North, of Little Rock
(distance) (direction) (Nearest Town)

(3) Topography: Hilly
(Hilly) (Flat) (Level)

(4) Purpose of Well: Domestic
(Domestic Irrigation
Municipal, Industrial, Other)

| Description & Color of Materials Sand, Clay, Red Clay, Shell, etc. | Thick- ness Feet | Depth Feet |
|---|------------------------|---------------|
| <u>Clay & chalk</u> | <u>0</u> | <u>32</u> |
| <u>blue dirt</u> | <u>32</u> | <u>80</u> |
| <u>Rock</u> | <u>80</u> | <u>93</u> |
| <u>Shell</u> | <u>93</u> | <u>110</u> |
| <u>Blue dirt & shell</u> | <u>110</u> | <u>115</u> |
| <u>Water sand</u> | <u>115</u> | <u>126</u> |

Information upon completion of well:

(1) Diameter 4 inches.

(2) Total Depth 126 feet.

(3) Water Level 90 feet below top of ground.

(4) Cased to Bottom Size 2'


(5) Screen: Size 1 1/4", Length 5 ft

(6) Were any formations sealed against pollution?
_____ yes, ✓ no.


If YES depth of formation _____

Why _____

Drillers Remarks: Good well

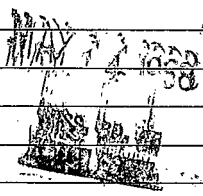

CODED

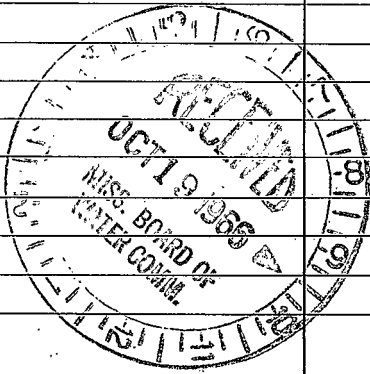

(Use Back Side)

Well No.

