

Neshoba
Q 4
5-67

3 13 P

MISSISSIPPI BOARD OF WATER COMMISSIONERS

WATER WELL DRILLERS LOG

Date: May 1, 1967 (When well drilled) Driller: M. J. Ray (Name) County: Neshoba (Where well is located)


(1) Owner of Land: J. M. Hill
(Name)
Philamiss R # 4
(Address)
(2) Location: 1/4 Sec 13, T9R13, S1E1/4, N1/4
10 miles East of Philamiss
(distance) (direction) (Nearest Town)
(3) Topography: (Hilly) (Flat) (Level)
(4) Purpose of Well: Domestic
(Domestic Irrigation, Municipal, Industrial, Other)

Description & Color of Materials Sand, Clay, Red Clay, Shell, etc.	Thick- ness Feet	Depth Feet
<u>Clay to 10 ft</u>		
<u>Sand to 73</u>		
<u>Graded in well pipe</u>		
<u>Coarse Sand</u>		

CODED

Information upon completion of well:

(1) Diameter 2 inches.
(2) Total Depth 73 feet.
(3) Water Level 60 feet below top of ground.
(4) Cased to 69, Size 2
(5) Screen: Size 1/2" mesh Length 4 ft
(6) Were any formations sealed against pollution?
_____ yes, no.

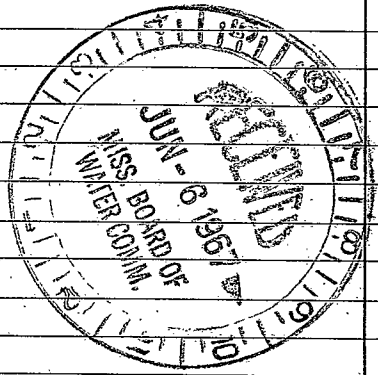

If YES depth of formation _____
Why _____
Drillers Remarks: _____
Yield in gpm: _____
Size pump: 3/4 HP
Type power: Electric

