

MISSISSIPPI BOARD OF WATER COMMISSIONERS

26

E 134

WATER WELL DRILLERS LOG

Date: 6-17 1965, Driller: Bob Williams County: Neshoba

(Name)

(1) Owner of Land: Carol Stephens
 (Name)
Collinsville, Route 2
 (Address)
 (2) Location: NW 1/4 SE 1/4 Sec. 36 T9 R13
30 West of Collinsville
 (direction) (Nearest Town)
 (3) Topography: Hilly
 (Hilly) (Flat) (Level)
 (4) Purpose of Well: Domestic
 (Domestic Irrigation
 Municipal, Industrial, Other)

Description & Color of Materials Sand, Clay, Red Clay, Shell, etc.	Thick- ness Feet	Depth Feet
<u>Red clay</u>	<u>10</u>	<u>1-10</u>
<u>Blue clay</u>	<u>40</u>	<u>10-50</u>
<u>White sand</u>	<u>30</u>	<u>81-80</u>
<u>Blue clay</u>	<u>111</u>	<u>81-180</u>
<u>gray sand</u>	<u>32</u>	<u>181-212</u>


Information upon completion of well:

(1) Diameter 2 inches.
 (2) Total Depth 212 feet.
 (3) Water Level 65 feet below top of ground.
 (4) Cased to 84, Size 2'
 (5) Screen Size 0 Length
 (6) Were any formations sealed against pollution?
✓ yes, _____ no.

If YES depth of formation _____

Why surface water

Drillers Remarks: _____

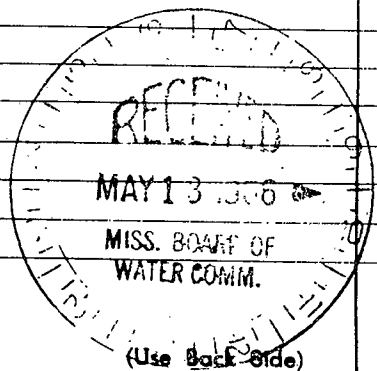

Well No.

