

NEBHOBA

WATER WELL DRILLERS LOG

Date: 5/19 <sup>3 138</sup> ~~1964~~, Driller: Bob Williamson County Nesbora

(Name)

5-19-64

(1) Owner of Land: Hubert Frazier  
(Name)  
Route #3, Collinsville, Miss  
(Address)

Description & Color of Materials  
Sand, Clay, Red Clay, Shell, etc.

Thick-  
ness  
Feet

Depth  
Feet

red sand  
white sand

15 1-15  
21 15-36

(2) Location: NE 1/4, SW 1/4, Sec. 25 T 9 R 3 E  
20 miles NW, of Meridian  
(distance) (direction) (Nearest Town)

(3) Topography: Hilly  
(Hilly) (Flat) (Level)

(4) Purpose of Well: Domestic  
(Domestic Irrigation  
Municipal, Industrial, Other)

Information upon completion of well:

(1) Diameter 2 inches.

(2) Total Depth 36 feet.

(3) Water Level 22 feet below top of ground.

CODED

(4) Cased to 32, Size 2 in.

(5) Screen: Size 2 in., Length 4 ft.


(6) Were any formations sealed against pollution?

no

If YES depth of formation \_\_\_\_\_

Why \_\_\_\_\_

Drillers Remarks: \_\_\_\_\_

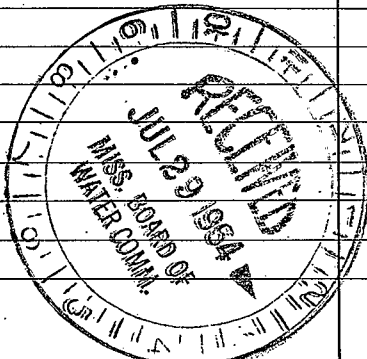

(Use Back Side)

Well No.

Mail this copy to Board of Water Commissioners 429 Miss. St. Jackson, Miss

