

Q9  
9-30-60

CODED WATER WELL DRILLERS LOG

CODED

Date: 9-30, 1960, Driller: B R Nicholas, County: Neshoba  
(Name)

(1) Owner of Land: Neshoba Co School  
(Name)  
Phila Miss (House)  
(Address)

Description & Color of Materials Sand, Clay, Red Clay Shell, etc.	Thick- ness Feet	Depth Feet
sand & clay	1	75
water sand	75	96

(2) Location: 1/4, 1/4, Sec. 17 T9 R13  
9 miles south of  
(distance) (direction) (Nearest Town)

(3) Topography: (Hilly) (Flat) (Level)

(4) Purpose of Well: (Domestic Irrigation, Municipal, Industrial, Other)

Information upon completion of well:

(1) Diameter 6 inches.

(2) Total Depth 96 feet.

(3) Water Level 70 feet below top of ground.

(4) Cased to bottom, Size 3"

(5) Screen: Size 2", Length 12'


(6) Were any formations sealed against pollution?  
yes, no.

If YES depth of formation

Why

Drillers Remarks: good well

CODED

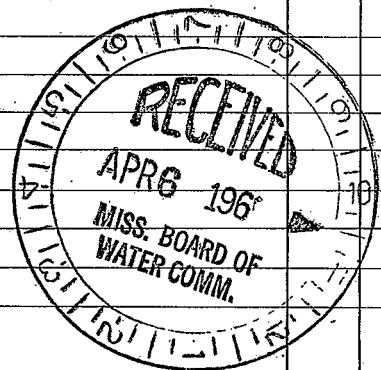

(Use Back Side)

Well No.

②