

Q10

WATER WELL DRILLERS LOG

CODED

Date: 4-4, 1963, Driller: Ray Cox
(Name)

County Neshoba


(1) Owner of Land: Abell Smith
(Name)

(Address) 139 B
(2) Location: 1/4, 1/4, Sec. 23 T9R13,
8 miles E of Hence,
(distance) (direction) (Nearest Town)
(3) Topography: V
(Hilly) (Flat) (Level)
(4) Purpose of Well: Domestic
(Domestic Irrigation
Municipal, Industrial, Other)

Description & Color of Materials Sand, Clay, Red Clay, Shell, etc.	Thick- ness Feet	Depth Feet
<u>0 to 6' Red Clay</u>		
<u>6 to 10' Sand (Red)</u>		
<u>10-38' Blue Clay</u>		
<u>38-49' Green Clay</u>		
<u>49-138' Blue Chalk</u>		
<u>138-140' Fine grey sand</u>		
<u>140-220' Blue chalk</u>		
<u>220-228' Light Gray sand</u>		
<u>228-235' Sand + Chalk</u>		

Information upon completion of well:

(1) Diameter 2" inches.
(2) Total Depth 235' feet.
(3) Water Level 122 feet below top of ground.
(4) Cased to 167', Size 2"
(5) Screen: Size _____, Length _____
(6) Were any formations sealed against pollution?
_____ yes, _____ no.

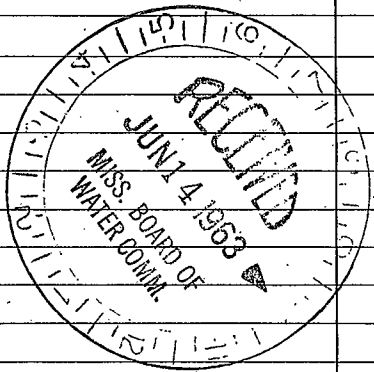

If YES depth of formation _____
Why _____

Drillers Remarks: James Well Drilling

(Use Back Side)

Well No.

