

CODED

MISSISSIPPI  
BOARD OF WATER COMMISSIONERS  
416 North State Street  
Jackson, Mississippi 39201

CODED

WATER WELL DRILLERS LOG

Neshoba  
Q 14  
2-69

2-13 1969 Ogletree Drilling Neshoba  
date well completed firm name county well located

LANDOWNER:

John Smith

description of fomations encountered

from to /

Red clay 0 20  
Red sand 20 50  
Blue chalk 80 120  
Red sand 120 170  
Blue chalk 170 509  
White sand 509 675

(mailing address)

WELL LOCATION:

sec 14 T 90 N R 13 E  
4 miles East of Hound.  
(distance) (direction) (nearest town)

WELL PURPOSE: Home, irrigation, municipal, industrial

WELL COMPLETION DATA:

- (1) diameter (inches) 4
- (2) total depth (feet) 675
- (3) static water level (feet) 30 below top of ground
- (4) casing Steel 2.52 (material) (depth)
- (5) screen 20 1.75-655 (length) (depth to top)
- 2 (size) 12.5 (material) (yield gpm)
- (6) pump 2 (HP) 12.5 (yield gpm)
- R.P.A. (type power)
- (7) electric log (yes or no)

(organization running log)

(8) how well bottom plugged Painted

MAR 5 1969

MISS. Bd. OF WATER COMM

DRILLERS REMARKS:

If well telescopes please sketch and show depths.

GROUND LEVEL

0 = 252

1/4" Cassin


2" Cassin

252  
655

2" screens

655

6.75

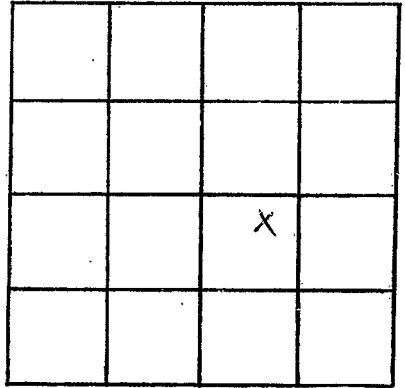

SECTION 14

Please indicate well location X.

ADDITIONAL INFORMATION

If more than one screen, show locations of each on sketch.