

Neshoba
Q 19
2-10-70

MISSISSIPPI
BOARD OF WATER COMMISSIONERS
416 North State Street
Jackson, Mississippi 39201

CODED

WATER WELL DRILLERS LOG

2-10-1970 date well completed
Williamson Drilling Co. firm name
Neshoba county well located

LANDOWNER: <u>Wayne Gurgel</u>	description of formations encountered	from	to
<u>Wt 2</u> <u>Collinsville, Miss</u> (mailing address)	<u>red clay</u>	<u>0</u>	<u>8</u>
WELL LOCATION: sec <u>35</u> T <u>90</u> N R <u>13</u> E <u>5</u> miles <u>S</u> of <u>Home</u> (distance) (direction) (nearest town)	<u>gray clay</u>	<u>8</u>	<u>30</u>
WELL PURPOSE: <u>Home</u> (home, irrigation, municipal, industrial)	<u>blue clay</u>	<u>30</u>	<u>45</u>
WELL COMPLETION DATA: (1) diameter (inches) <u>2</u>	<u>gray sand</u>	<u>45</u>	<u>68</u>
(2) total depth (feet) <u>68</u>			
(3) static water level (feet) <u>20</u> <u>below</u> top of ground			
(4) casing <u>galv</u> <u>63</u> (material) (depth)			
<u>2</u> if telescope see back. (size)			
(5) screen <u>5</u> <u>63</u> (length) (depth to top)			
<u>2</u> <u>plastic</u> (size) (material)			
(6) pump <u>1/2</u> <u>5</u> (HP) (yield gpm)			
<u>elect</u> (type power)			
(7) electric log <u>no</u> (yes or no)			
<u>no</u> (organization running log)			
(8) how well bottom plugged <u>Cap</u>			


DRILLERS REMARKS:

FEB 27 1970

MISS. BD. OF
WATER COMM.

If well telescopes please sketch and show depths.

GROUND LEVEL

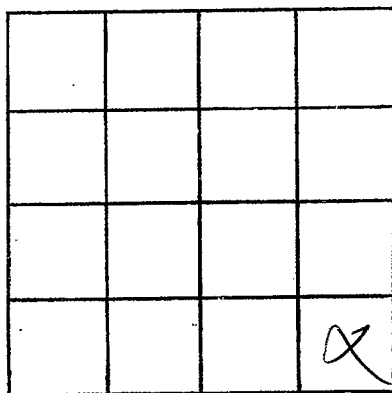

SECTION 35

Please indicate well location X.

ADDITIONAL INFORMATION

If more than one screen,
show locations of each on sketch.