

Neshoba  
Q 22  
9-6-71

MISSISSIPPI  
BOARD OF WATER COMMISSIONERS  
416 North State Street  
Jackson, Mississippi 39201

**CODED**

WATER WELL DRILLERS LOG

9-6 1971 R.R. Nickerson Neshoba  
date well completed firm name county well located

LANDOWNER: Frank Hodge  
Union  
Miss  
(mailing address)

description of fomations encountered	from	to
Clay	0	9
Wind Blown Sand	9	35
Part of Chalk	35	77
Water Sand	77	85

WELL LOCATION:  
sec 14 T 9 N R 13 E  
11 miles East of Union  
(distance) (direction) (nearest town)

WELL PURPOSE: Home  
(home, irrigation, municipal, industrial)

- WELL COMPLETION DATA:
- (1) diameter (inches) 4 1/4"
  - (2) total depth (feet) 85'
  - (3) static water level (feet) 47' below above top of ground.
  - (4) casing Lead 80'  
(material) (depth)  
2"  
(size) If telescope see back.
  - (5) screen 5' 85'  
(length) (depth to top)  
1/4" steel  
(size) (material)
  - (6) pump 1 10  
(HP) (yield gpm)  
Elect.  
(type power)
  - (7) electric log no  
(yes or no)  
  
(organization running log)
  - (8) how well bottom plugged


**CODED**

DRILLERS REMARKS:

NOV 19 1971

If well telescopes please sketch and show depths.

GROUND LEVEL

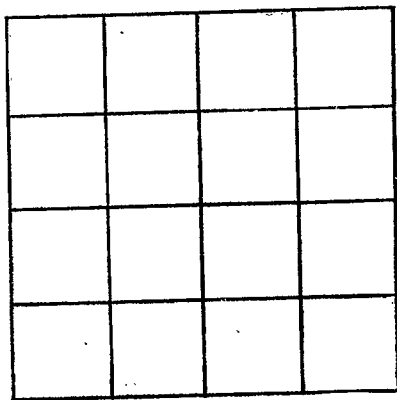

SECTION \_\_\_\_\_

Please indicate well location X.

ADDITIONAL INFORMATION

If more than one screen, show locations of each on sketch.