

NESHOBA

Q 27

3-12-74

MISSISSIPPI BOARD OF WATER COMMISSIONERS 416 North State Street Jackson, Mississippi 39201

CODED

WATER WELL DRILLERS LOG

3-12-74 date well completed

Williamson Drilling Co. firm name

Neshoba county well located

LANDOWNER: R.L. Williams

RT3 Box 245

Union Ins. (mailing address)

WELL LOCATION:

sec. 21 T. 9 N. S. R. 3 E. W.

2 miles south of Grouse (distance) (direction) (nearest town)

WELL PURPOSE: Home (home, irrigation, municipal, industrial)

WELL COMPLETION DATA:

- (1) diameter (inches) 4
(2) total depth (feet) 256
(3) static water level (feet) 150 below top of ground.
(4) casing plastic, 246 (material) (depth) 4 (size) If telescope see back.
(5) screen 10 (length) 246 (depth to top) 4 (size) plastic (material)
(6) pump 1/2 (HP) 12 (yield gpm) Elec. (type power)
(7) electric log no (yes or no) no (organization running log)

(8) how well bottom plugged Backwash Valve

DRILLERS REMARKS:

description of formations encountered

Table with 2 columns: from, to. Rows: 0-10, 10-37, 37-80, 80-112, 112-256


red clay, red sand, white sand, blue clay, sand

CODED



If well telescopes please sketch and show depths.

GROUND LEVEL

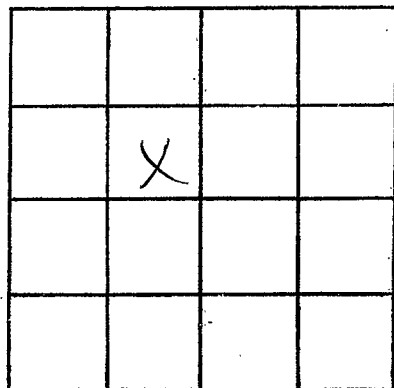

SECTION 21

Please indicate well location X.

ADDITIONAL INFORMATION

If more than one screen,  
show locations of each on sketch.