

MISSISSIPPI DEPARTMENT OF NATURAL RESOURCES

Bureau of Land and Water Resources

Southport Mall

P.O. Box 10631

Jackson, Mississippi 39209

WATER WELL DRILLERS LOG

NESHABA  
Q28

CODED

6-28-1986 date well completed      1986 Smith's well Drilling firm name      neshoba county well located

LANDOWNER: Paul Gofarth

description of formations encountered

from to

Red clay	0	15
Blue clay	15	80
Blue clay + sand	80	110
Blue clay	110	160
Sand + clay	160	235

(mailing address)

WELL LOCATION:

sec. 3 T. 9 N. R. 13 E.  
20 miles south of Phila  
(distance) (direction) (nearest town)


WELL PURPOSE:

(home, Irrigation, municipal, industrial)

WELL COMPLETION DATA:

- (1) diameter (inches) 4
- (2) total depth (feet) 235
- (3) static water level (feet) 40 below top of ground.
- (4) casing PVC, 150  
(material) (depth)  
(size) if telescope see back.
- (5) screen \_\_\_\_\_  
(length) (depth to top)  
(size) (material)
- (6) pump 1 1/2, 30  
(HP) (yield gpm)  
E  
(type power)
- (7) electric log (yes or no)  
(organization running log)

CODED

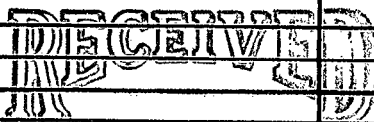

AUG 4 1986


Department of Natural Resources  
Bureau of Land & Water Resources

(8) how well bottom plugged open

DRILLERS REMARKS:

If well telescopes please sketch and show depths.

GROUND LEVEL

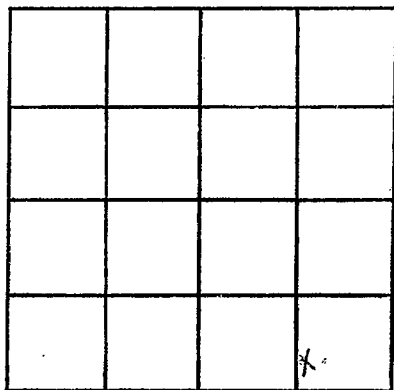

SECTION \_\_\_\_\_

Please indicate well location X.

ADDITIONAL INFORMATION

If more than one screen,  
show locations of each on sketch.