

MISSISSIPPI DEPARTMENT OF NATURAL RESOURCES

Bureau of Land and Water Resources

Southport Mall

P.O. Box 10631

Jackson, Mississippi 39209

WATER WELL DRILLERS LOG

Neshoba
Q29

CODED

6-26-86
date well completed

19 Smith's well drilling
firm name

Neshoba
county well located

LANDOWNER: Paul G. Farth

description of formations encountered

from to

Red Clay	0	12
Blue Clay	12	145
Clay & Sand	145	210

(mailing address)

WELL LOCATION:

sec. 3 T. 9 N. R. 13 E.
20 miles south of Phila.
(distance) (direction) (nearest town)

WELL PURPOSE:

(home, irrigation, municipal, industrial)

WELL COMPLETION DATA:

- (1) diameter (inches) 4
- (2) total depth (feet) 210
- (3) static water level (feet) 20 below top of ground.
- (4) casing PVC (material), (depth), (size) if telescope see back.
- (5) screen (length), (depth to top), (size), (material)
- (6) pump 1/2 (HP), 35 (yield gpm), E (type power)
- (7) electric log (yes or no), (organization running log)
- (8) how well bottom plugged open

CODED


RECEIVED
AUG 4 1986

Department of Natural Resources
Bureau of Land & Water Resources

DRILLERS REMARKS:

If well telescopes please sketch and show depths.

GROUND LEVEL

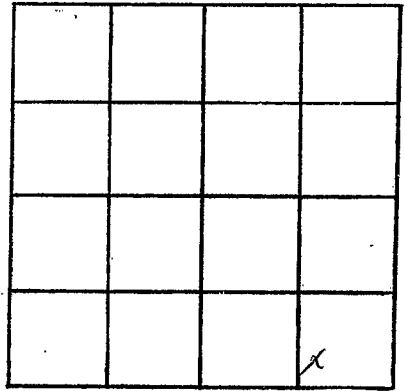

SECTION _____

Please indicate well location X.

ADDITIONAL INFORMATION

If more than one screen,
show locations of each on sketch.