

~~MISSISSIPPI BOARD OF WATER COMMISSIONERS~~

Neshoba
Q 7001
11/6/76

MISSISSIPPI
BOARD OF WATER COMMISSIONERS
416 North State Street
Jackson, Mississippi 39201

559
Phila.

WATER WELL DRILLERS LOG

11-6-76 19 Beck Smith Neshoba
date well completed firm name county well located

LANDOWNER:	description of formations encountered	from	to
Arcene Sharp	Clay	0	30
Phila. miss (mailing address)	Shale	30	60
	Gray sand	60	84

WELL LOCATION:
sec. 3 T 9 N R 13 E
2 miles of House
(distance) (direction) (nearest town)

WELL PURPOSE: home
(home, irrigation, municipal, industrial)

- WELL COMPLETION DATA:
- (1) diameter (inches) 2"
 - (2) total depth (feet) 84'
 - (3) static water level (feet) 55' below top of ground.
 - (4) casing galv (material) 78' (depth)
2" (size) if telescope see back.
 - (5) screen 5" (length) 75' (depth to top)
.008 (size) Stainless Steel (material)
 - (6) pump 3/4 HP (HP) (yield gpm)
elec (type power)
 - (7) electric log (yes or no)
(organization running log)
 - (8) how well bottom plugged back
wash valve


RECEIVED
DEC 3 1976

MISS. BD OF WATER COMM

DRILLERS REMARKS:

If well telescopes please sketch and show depths.

GROUND LEVEL

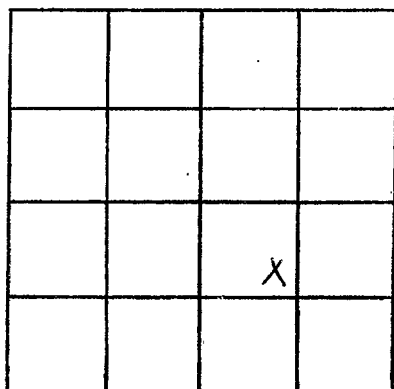

SECTION _____

Please indicate well location X.

ADDITIONAL INFORMATION

If more than one screen,
show locations of each on sketch.