

NESHOBA
 Q 2002
 2-22-77

MISSISSIPPI
 BOARD OF WATER COMMISSIONERS
 416 North State Street
 Jackson, Mississippi 39201

WATER WELL DRILLERS LOG

Neshoba

2-22-77 13P 19 Williamson Drilling Co. ~~Williamson~~
 date well completed firm name county well located

LANDOWNER: Wannie Thomas
W#3
Thomas Inc.
 (mailing address)

description of formations encountered	from	to
top soil	0	2
Blue Clay	0	11 1/2
red sand	8 1/4	20
white sand	60	55

WELL LOCATION:
 sec. 21 T 90 N R 13 E
2 miles SE of House
 (distance) (direction) (nearest town)

WELL PURPOSE: Staminal
 (home, irrigation, municipal, industrial)


- WELL COMPLETION DATA:
- (1) diameter (inches) 2
 - (2) total depth (feet) 75
 - (3) static water level (feet) 35 below above top of ground.
 - (4) casing PVC 70
 (material) (depth)
2 if telescope see back.
 (size)
 - (5) screen 5 70
 (length) (depth to top)
14 PVC
 (size) (material)
 - (6) pump 1 12
 (HP) (yield gpm)
Chat
 (type power)
 - (7) electric log no
 (yes or no)
no
 (organization running log)
 - (8) how well bottom plugged Rock
Wash Valve

RECEIVED
 MAY 2 - 1977

DRILLERS REMARKS:

If well telescopes please sketch and show depths.

GROUND LEVEL

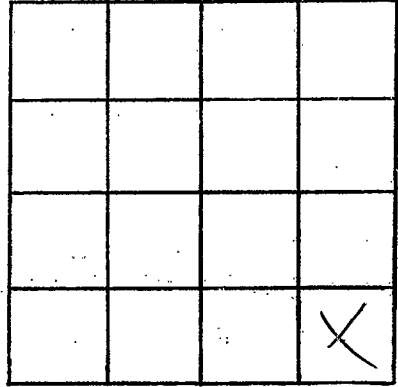

SECTION 21

Please indicate well location X.

ADDITIONAL INFORMATION

If more than one screen, show locations of each on sketch.