

**MISSISSIPPI  
BOARD OF WATER COMMISSIONERS**  
416 North State Street  
Jackson, Mississippi 39201

**NESHOBA**  
B. 2003  
4-30-77

13P

**WATER WELL DRILLERS LOG**

APRIL 30 1977 HAROLD POOLE NESHOBA  
date well completed: firm name: county well located:

**LANDOWNER:**  
FRANK CHESNEY  
RT 3, UNION, MISS.  
(mailing address) 39365

description of formations encountered	from	to
Surface Clay with mica millstone	0'	7'

**WELL LOCATION:**  
sec. 20 T. 9 N R. 13 E  
1 1/2 miles SOUTH of HOUSE  
(distance) (direction) (nearest town)

Sand - Brownish in color - then white + yellowed	7'	29'
--	----	-----

**WELL PURPOSE:** HOME  
(home, irrigation, municipal, industrial)

Layer of white clay	29'	32'
---------------------	-----	-----


**WELL COMPLETION DATA:**

- (1) diameter (inches) 2" + 4" / 88'
- (2) total depth (feet) 88'
- (3) static water level (feet) 63 below top of ground.
- (4) casing PVC 83 (material) (depth)
- (5) screen 5' 83 (length) (depth to top)  
2" x 5" PVC 10-82 (size) (material)
- (6) pump 1 7 (HP) (yield gpm)  
220 ELECTRIC (type power)
- (7) electric log (yes or no)

Sand with Reddish tint	32'	65'
Layer of Hard fine sand	65'	70'
White medium coarse sand	70'	88'

(organization running log)  
(8) how well bottom plugged Sand  
Shells

**DRILLERS REMARKS:**  
Cased with 4" PVC to 31' with 2" inside

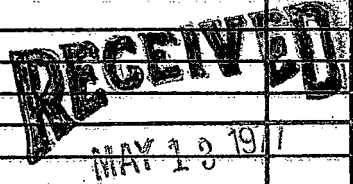

MAY 19 1977

MISSISSIPPI BOARD OF WATER COMMISSIONERS

