

NESHOPA
Q 2005
5-7-79

MISSISSIPPI
 BOARD OF WATER COMMISSIONERS
 416 North State Street
 Jackson, Mississippi 39201

WATER WELL DRILLERS LOG

5-7-79 19 Williamson Drilling Co. Neshoba
 date well completed firm name county well located

LANDOWNER: Louis Wilson
RT 3 Box 282
Union, Ms.
 (mailing address)

description of formations encountered	from	to
<u>top soil</u>	<u>0</u>	<u>2</u>
<u>red clay</u>	<u>2</u>	<u>8</u>
<u>shale</u>	<u>8</u>	<u>70</u>
<u>sand</u>	<u>70</u>	<u>85</u>

WELL LOCATION:
 sec 4 T 90N R 13E
2 miles North of House
 (distance) (direction) (nearest town)

WELL PURPOSE: Home
 (home, irrigation, municipal, industrial)

WELL COMPLETION DATA:

(1) diameter (inches) 2

(2) total depth (feet) 85

(3) static water level (feet) 75 below above top of ground.

(4) casing PVC 80
 (material) (depth)

2 (size) if telescope see back.

(5) screen 5 80
 (length) (depth to top)

12 PVC
 (size) (material)

(6) pump 7
 (HP) (yield gpm)

Electric
 (type power)

(7) electric log no
 (yes or no)

no
 (organization running log)


(8) how well bottom plugged Cap

Miss. Board of Water Comm.
 JUN 12 1979
RECEIVED

DRILLERS REMARKS:

If well telescopes please sketch and show depths.

GROUND LEVEL

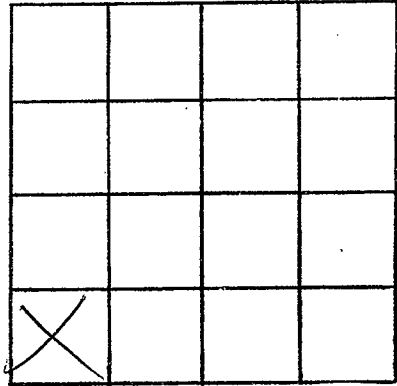

SECTION 4

Please indicate well location X.

ADDITIONAL INFORMATION

If more than one screen,
show locations of each on sketch.