

Neshoba
R 2007

MISSISSIPPI
BOARD OF WATER COMMISSIONERS
416 North State Street
Jackson, Mississippi 39201

WATER WELL DRILLERS LOG

Jan 9 1987 HAROLD POOLE NESHOTIA
date well completed firm name county well located

LANDOWNER: CLYDE DAVIS

description of formations encountered from to

R.T. 2 BOX 95
COLLINSVILLE, MISS. 39326
(mailing address)

Top Soil Red Clay 0 6'
White Chalk Clay 6' 16'

WELL LOCATION:

Blue Shell 16' 30'

sec 35 T 9 N R 13 E
7 miles NORTH of COLLINSVILLE
(distance) (direction) (nearest town)

Traces of Lignite 30' 31'
THIN LAYER SHELL 31' 33'

WELL PURPOSE: HOME
(home, irrigation, municipal, industrial)

Fine Mulberry Sand
with Brown Lent 33' 100'

WELL COMPLETION DATA:

(1) diameter (inches) 2"
(2) total depth (feet) 220'
(3) static water level (feet) 15' above top of ground.
(4) casing 2" PVC, 120' WITH SHELL TRAP AT 115'
(size) (material) (depth) (if telescope see back.)

Blue Shell 100 120'
Sand + Shell 120 190'
Sand 190 220'

(5) screen (length) (depth to top)

(6) pump 1/2 (HP) 8 (yield gpm)
110 (type power)

(7) electric log (yes or no)

(organization running log)

(8) how well bottom plugged OPEN


DEPT. OF NATURAL RESOURCES
BUREAU OF LAND & WATER RESOURCES

FEB 24 1987

RECEIVED

DRILLERS REMARKS: Customer
used his old pump
& tanks

If well telescopes please sketch and show depths.

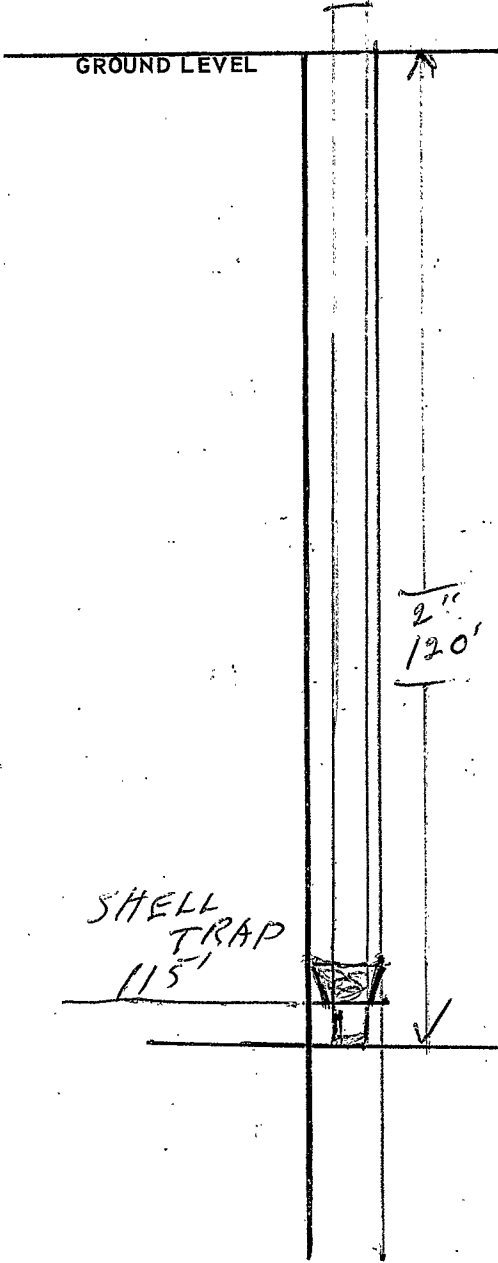

SECTION _____

Please indicate well location X.

ADDITIONAL INFORMATION

If more than one screen, show locations of each on sketch.