

A 1

WATER WELL DRILLERS LOG

11-2-61

Date: 11-2, 1961, Driller: RRB Nicholas, County Newton

(Name)

- (1) Owner of Land: Virgil Goss
(Name)
Union Miss Rt 3
(Address)
- (2) Location: $\frac{1}{4}$, NW $\frac{1}{4}$, Sec. 7 T 8^N R 10^E
1 1/2 miles West, of Union
(distance) (direction) (Nearest Town)
- (3) Topography: X
(Hilly) (Flat) (Level)
- (4) Purpose of Well: Domestic
(Domestic Irrigation
Municipal, Industrial, Other)

Description & Color of Materials Sand, Clay, Red Clay, Shell, etc.	Thick- ness Feet	Depth Feet
<u>Clay & Sand</u>	<u>1</u>	<u>30</u>
<u>Clay & Sand</u>	<u>30</u>	<u>60</u>
<u>Water Sand</u>	<u>18</u>	<u>78</u>


Information upon completion of well:

- (1) Diameter 4 1/2 inches.
- (2) Total Depth 78 feet.
- (3) Water Level 55 feet below top of ground.
- (4) Cased to Point, Size 2"
- (5) Screen: Size 1 1/2", Length 5'
- (6) Were any formations sealed against pollution?
_____ yes, _____ no.

If YES depth of formation _____

Why _____

Drillers Remarks: Good well

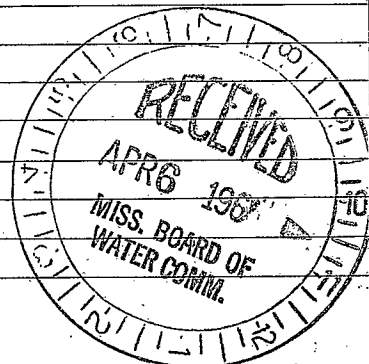

(Use Back Side)

Well No.

