

CODED

MISSISSIPPI
BOARD OF WATER COMMISSIONERS
416 North State Street
Jackson, Mississippi 39201

WATER WELL DRILLERS LOG

Newton
A5
6-7-69

6-7 1969 McDonald Hill Inc Newton
date well completed firm name county well located

LANDOWNER Billy Mae Tate

Conehatta Miss

(mailing address)

WELL LOCATION:

sec. 28 T. 8 N. R. 10 E.
6 miles north of Conehatta
(distance) (direction) (nearest town)

WELL PURPOSE: home
(home, irrigation, municipal, industrial)

WELL COMPLETION DATA:

- (1) diameter (inches) 4
- (2) total depth (feet) 310
- (3) static water level (feet) 129 below above top of ground.
- (4) casing 4" 252,
(material) (depth)
if telescope see back.
(size)
- (5) screen _____
(length) (depth to top)
(size) (material)
- (6) pump 3/4 _____
(HP) (yield gpm)
Meyers submersible
(type power)
- (7) electric log _____
(yes or no)
(organization running log)
- (8) how well bottom plugged _____

description of formations encountered

from to

clay	0	14
shell + st rock	14	45
sand	45	55
shell	55	80
fine sand	80	120
coarse sand	125	165
sand	165	200
shell	200	208
st sand + rock	208	220
shell	220	270
st rock + sand	270	310


JUN 12 1969

MISS. BD. OF
WATER COMM.

DRILLERS REMARKS:

If well telescopes please sketch and show depths.

GROUND LEVEL

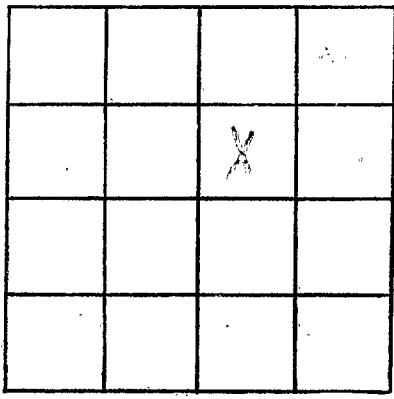

SECTION 206

Please indicate well location X.

ADDITIONAL INFORMATION

Lined area for additional information.

If more than one screen, show locations of each on sketch.