

AL

8-24-63

WATER WELL DRILLERS LOG

newton


Date: 8/24, 1963, Driller: Font Willing Sec County Scott  
 (Name)

(1) Owner of Land: R. A. McAuliff  
 (Name)  
Trush Miss  
 (Address)  
 (2) Location: 1/4, 1/4, Sec. 12 T8N R10E  
7 miles East of Sebastopol  
 (distance) (direction) (Nearest Town)  
on Union Hwy  
 (3) Topography: \_\_\_\_\_  
 (Hilly) (Flat) (Level)  
 (4) Purpose of Well: Chickens  
 (Domestic Irrigation  
 Municipal, Industrial, Other)

Description & Color of Materials Sand, Clay, Red Clay, Shell, etc.	Thick- ness Feet	Depth Feet
Clay	0	17
Sand		40
Blue Clay		75
Lime, Coal + Shell		123
Hard Shale + Sh. Rock		207
Hard Rock + Shale		286
Shale + Sh. Sand		400
Shale		454
Shale		472
Sand + Sh. Shale		487
Shale + Sh. Sand		493
Shale		502
Rock		504
Hard Shale		513

Information upon completion of well:

(1) Diameter 2" inches.  
 (2) Total Depth 487 feet.  
 (3) Water Level 77 feet below top of ground.  
 (4) Cased to 472, Size 2"  
 (5) Screen: Size 2", Length 15  
 (6) Were any formations sealed against pollution?  
 \_\_\_\_\_ yes, X no.

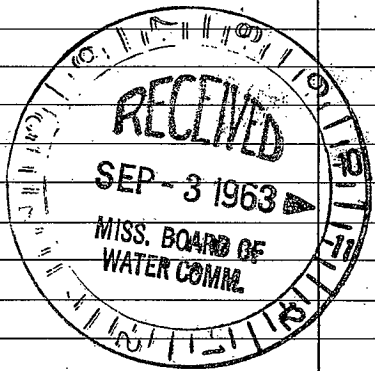

If YES depth of formation \_\_\_\_\_  
 Why \_\_\_\_\_  
 Drillers Remarks: \_\_\_\_\_

(Use Back Side)

Well No.

