

BAB

WATER WELL DRILLERS LOG

Newton Co.

7-15-60

Date: 7-15, 1960, Driller: R. B. Nicholas County: Newton

(Name)

(1) Owner of Land: Victor Ezell
 Union Miss.
(Name)
(Address)

(2) Location: SW 1/4, SE 1/4, Sec. 20 T8R11,
 8 miles S.W. of Union
(distance) (direction) (Nearest Town)

(3) Topography: Flat
(Hilly) (Flat) (Level)

(4) Purpose of Well: Home Well
(Domestic Irrigation
Municipal, Industrial, Other)

Description & Color of Materials Sand, Clay, Red Clay, Shell, etc.	Thick- ness Feet	Depth Feet
Green Clay	1	15
Black	15	42
Mix Sand	42	55
Water Sand	55	69

Information upon completion of well:

(1) Diameter $4\frac{1}{2}$ inches.

(2) Total Depth 69 feet.

(3) Water Level 14 feet below top of ground.

(4) Cased to 63, Size 2"


(5) Screen: Size 10, Length $6\frac{1}{16}$

(6) Were any formations sealed against pollution?
 yes, no

If YES depth of formation _____

Why _____

Drillers Remarks: good well

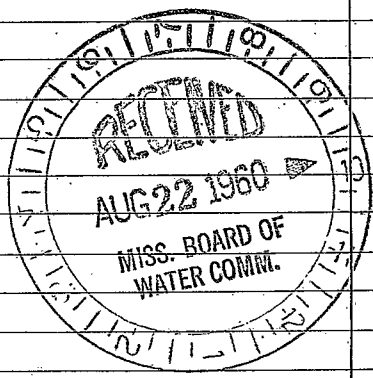

(Use Back Side)

Well No.

[The page contains extremely faint and illegible text, likely bleed-through from the reverse side of the document. The text is scattered across the page and cannot be transcribed accurately.]