

**MISSISSIPPI
BOARD OF WATER COMMISSIONERS**
416 North State Street
Jackson, Mississippi 39201

WATER WELL DRILLERS LOG

NEWTON
A 10
3-68

3-5-1968 date well completed COMANS Drilling Service firm name Newton county well located

LANDOWNER: Billy Brown

description of formations encountered	from	to
Clay	0	18
Sand	18	30
Clay	30	120
Sand	170	180
Clay	180	240
SAND	240	260

Comalata R#1
Miss
(mailing address)


WELL LOCATION:
sec. 2 T. 8 N. R. 10 E. S. W
4 miles E of Sebastopol
(distance) (direction) (nearest town)

WELL PURPOSE: HOME
(home, irrigation, municipal, industrial)

WELL COMPLETION DATA:


- (1) diameter (inches) 5"
- (2) total depth (feet) 260
- (3) static water level (feet) 90 below above top of ground.
- (4) casing 5" 189
(material) (depth)
- _____ if telescope see back.
(size)
- (5) screen _____
(length) (depth to top)
- _____ (size) _____ (material)
- (6) pump _____
(HP) (yield gpm)
- _____ (type power)
- (7) electric log _____
(yes or no)
- _____ (organization running log)
- (8) how well bottom plugged _____

DRILLERS REMARKS: _____

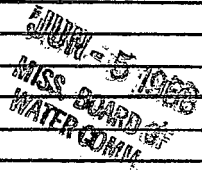

If well telescopes please sketch and show depths.

GROUND LEVEL

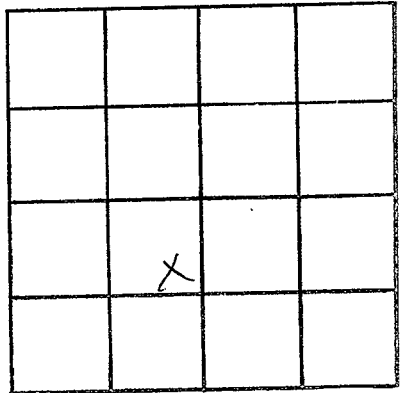

SECTION 2

Please indicate well location X.

ADDITIONAL INFORMATION

If more than one screen, show locations of each on sketch.