

NEWTON

A 11

2-68

MISSISSIPPI
 BOARD OF WATER COMMISSIONERS
 416 North State Street
 Jackson, Mississippi 39201

WATER WELL DRILLERS LOG

2-50

198 Common Drilling Service

Newton

date well completed

firm name

county well located

LANDOWNER: Ben Boykin

description of formations encountered

from

to

Corubatta Route 1st

Clay

0 60

Miss.
(mailing address)

Sand

60 89

Clay

89 195

WELL LOCATION:

Sand

195 210

sec 4 T 8 N R 10 E
S W

Clay

210 250

Sand

250 255

3 miles SE of Substold
(distance) (direction) (nearest town)

WELL PURPOSE: Home
(home, irrigation, municipal, industrial)

WELL COMPLETION DATA:


- (1) diameter (inches) 2"
- (2) total depth (feet) 255
- (3) static water level (feet) 90 below above top of ground.
- (4) casing _____ (material) _____ (depth) _____
_____ if telescope see back.
(size)
- (5) screen _____ (length) _____ (depth to top)
_____ (size) _____ (material)
- (6) pump _____ (HP) _____ (yield gpm)
_____ (type power)
- (7) electric log _____ (yes or no)
_____ (organization running log)
- (8) how well bottom plugged _____

DRILLERS REMARKS:

NOV-5-1968
 MISS. BOARD OF
 WATER COMM.

If well telescopes please sketch and show depths.

GROUND LEVEL

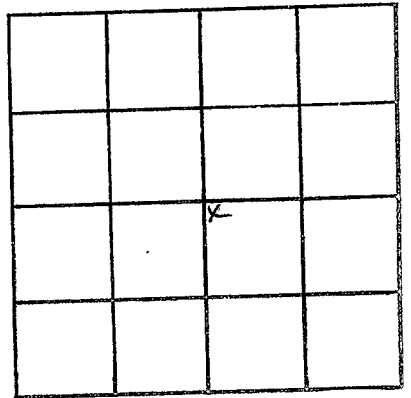

SECTION 4

Please indicate well location X.

ADDITIONAL INFORMATION

If more than one screen, show locations of each on sketch.