

Newton
A 15
2-3-69

MISSISSIPPI
BOARD OF WATER COMMISSIONERS CODED
416 North State Street
Jackson, Mississippi 39201

WATER WELL DRILLERS LOG

21.3.69 date well completed
McDONALD & HILL firm name
NEWTON county well located

LANDOWNER: N. J. Moudy
P.O. UNION
(mailing address)

WELL LOCATION:
sec. 10 T. 8 N. R. 10 E
S W
10 miles WEST of UNION
(distance) (direction) (nearest town)

WELL PURPOSE:
(home, irrigation, municipal, industrial)

WELL COMPLETION DATA:

- (1) diameter (inches) 4"
- (2) total depth (feet) 250'
- (3) static water level (feet) 89' below top of ground.
- (4) casing BLK 189" (material) (depth)
4" (size) if telescope see back.
- (5) screen (length) (depth to top) (size) (material)
- (6) pump 1/2 (HP) 10 (yield gpm)
220 (type power)
- (7) electric log NO (yes or no)
NO (organization running log)
- (8) how well bottom plugged OPEN

description of formations encountered	from	to
CLAY ST SAND	0	30
SHALE ST SAND	30	50
SHALE	50	60
SAND ST SHALE	60	120
Shale Sand	120	144
Shale	144	150
ROCK	150	151
SANDY	151	160
Shale	160	180
Shale	180	203
ROCK SHALE	203	216
SANDY	216	230
Gravel Sand	230	250


CODED

FEB 17 1969
MISS. Bd. OF WATER COMMISSIONERS

DRILLERS REMARKS:

If well telescopes please sketch and show depths.

GROUND LEVEL

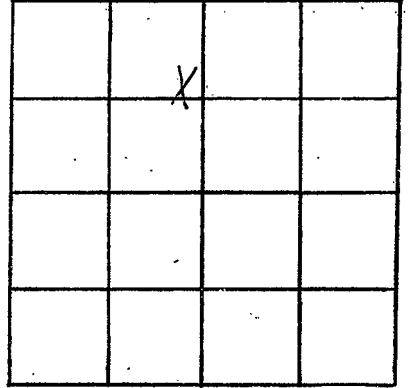

SECTION 10

Please indicate well location X.

ADDITIONAL INFORMATION

If more than one screen, show locations of each on sketch.