

Newton
A18
3-13-68

MISSISSIPPI
 BOARD OF WATER COMMISSIONERS
 416 North State Street
 Jackson, Mississippi 39201

CODED

WATER WELL DRILLERS LOG

3-13 date well completed 1968 Conrad Drilling Service firm name Newton county well located

LANDOWNER: Ruth Chapel Church

description of formations encountered	from	to
---------------------------------------	------	----

R.H. Cometta Min
 (mailing address)

<u>Red Clay</u>	<u>0</u>	<u>28</u>
<u>Sand</u>	<u>28</u>	<u>40</u>
<u>Red Clay</u>	<u>57</u>	<u>140</u>
<u>Sand</u>	<u>140</u>	<u>198</u>
<u>Diplo Clay</u>	<u>198</u>	<u>240</u>
<u>Clay + Sand</u>	<u>248</u>	<u>295</u>
<u>Sand</u>	<u>298</u>	<u>298</u>

WELL LOCATION:
 sec 5 T 8 N R 10 E
 S W
4 miles S.E. of Sebastopol
 (distance) (direction) (nearest town)

WELL PURPOSE: Church + Porch
 (home, irrigation, municipal, industrial)

WELL COMPLETION DATA:

- (1) diameter (inches) 2"
- (2) total depth (feet) 295
- (3) static water level (feet) 165 below top of ground.
- (4) casing Steel, 281,
 (material) (depth)
 _____ if telescope see back.
 (size)
- (5) screen _____,
 (length) (depth to top)
 _____,
 (size) (material)
- (6) pump _____,
 (HP) (yield gpm)

 (type power)
- (7) electric log X
 (yes or no)

 (organization running log)
- (8) how well bottom plugged _____

CODED


FEB 12 1969

MISS. Bd. OF
 WATER COMMISSIONERS

DRILLERS REMARKS: Off SA
Bottom To Alumina
Sand

If well telescopes please sketch and show depths.

GROUND LEVEL

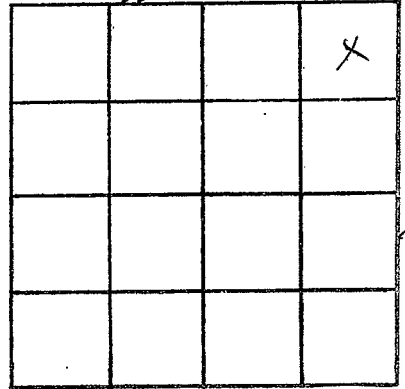

SECTION 3

Please indicate well location X.

ADDITIONAL INFORMATION

If more than one screen,
show locations of each on sketch.