

Newton
A 19
6-24-68

MISSISSIPPI
BOARD OF WATER COMMISSIONERS
416 North State Street
Jackson, Mississippi 39201

CODED

WATER WELL DRILLERS LOG

624 date well completed 1968 firm name Common Drilling Service county well located Newton

LANDOWNER: Austin Gunning

description of formations encountered from to

Combatta R#2 Min
(mailing address)

WELL LOCATION:

sec. 15 T. 8 N. R. 10 E. S. W.
6 miles S of Sebastopol
(distance) (direction) (nearest town)

WELL PURPOSE: Home
(home, irrigation, municipal, industrial)

WELL COMPLETION DATA:

- (1) diameter (inches) 2"
- (2) total depth (feet) 300
- (3) static water level (feet) 102 below above top of ground.
- (4) casing Steel, 231 (material), (depth)
_____ if telescope see back.
(size)
- (5) screen _____ (length), _____ (depth to top)
(size), _____ (material)
- (6) pump 1st, 280 (HP), (yield gpm) 4
(type power)
- (7) electric log _____ (yes or no)
(organization running log)
- (8) how well bottom plugged _____

DRILLERS REMARKS:

description of formations encountered	from	to
<u>Clay</u>	<u>0</u>	<u>14</u>
<u>Silt sand</u>	<u>14</u>	<u>22</u>
<u>Clay & shell</u>	<u>22</u>	<u>36</u>
<u>Clay</u>	<u>36</u>	<u>108</u>
<u>Sand</u>	<u>108</u>	<u>178</u>
<u>Clay & shell</u>	<u>178</u>	<u>240</u>
<u>Dark sand</u>	<u>240</u>	<u>246</u>
<u>Grey clay</u>	<u>246</u>	<u>290</u>
<u>Sand</u>	<u>290</u>	<u>300</u>


CODED

FEB 12 1969

MISS. BD. OF
WATER COMM.

If well telescopes please sketch and show depths.

GROUND LEVEL

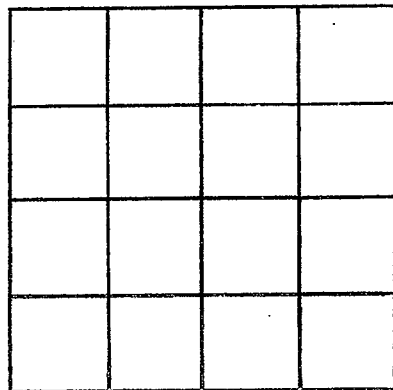

SECTION 15

Please indicate well location X.

ADDITIONAL INFORMATION

If more than one screen, show locations of each on sketch.