

Newton  
A 20  
12-19-68

MISSISSIPPI  
BOARD OF WATER COMMISSIONERS  
416 North State Street  
Jackson, Mississippi 39201

**CODED**

WATER WELL DRILLERS LOG

12-19 1968 *Common Drilling Service Corporation*  
date well completed firm name county well located

LANDOWNER: *David Green*

description of formations encountered from to

*R#5 Union Minn*  
(mailing address)

*Red Clay* 0 30

WELL LOCATION:  
sec. *24* T. *8* N R. *10* E  
S W  
*6* miles *west* of *Union*  
(distance) (direction) (nearest town)

*Red Sand* 30 45

WELL PURPOSE: *Home*  
(home, irrigation, municipal, industrial)

*Dark Clay* 45 130

WELL COMPLETION DATA:

*White Sand* 130 148

(1) diameter (inches) *2"*  
(2) total depth (feet) *225'*  
(3) static water level (feet) *70* below above top of ground.  
(4) casing *Steel*, *168*,  
(material) (depth)

*Dark Clay* 148 206

\_\_\_\_\_ If telescope see back.  
(size)

*Green Sand* 206 285

(5) screen *None*, \_\_\_\_\_  
(length) (depth to top)  
\_\_\_\_\_ (size) \_\_\_\_\_ (material)

(6) pump \_\_\_\_\_ (HP) \_\_\_\_\_ (yield gpm)  
\_\_\_\_\_ (type power)

(7) electric log *X*  
(yes or no)  
\_\_\_\_\_ (organization running log)

(8) how well bottom plugged \_\_\_\_\_

**CODED**


FEB 1 8 1969

MISS. BD. OF  
WATER COMML.

DRILLERS REMARKS: *Open*  
*Ballon to Union*  
*Sand*

If well telescopes please sketch and show depths.

GROUND LEVEL

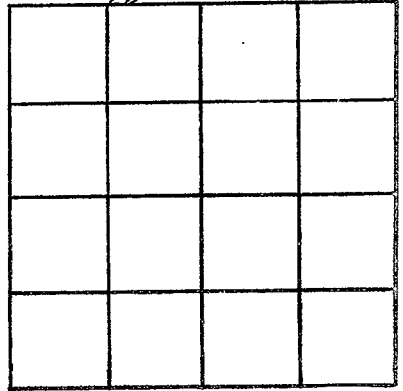

SECTION 24

Please indicate well location X.

ADDITIONAL INFORMATION

If more than one screen,  
show locations of each on sketch.