

Newton
A 24
8-12-69

MISSISSIPPI
BOARD OF WATER COMMISSIONERS
416 North State Street
Jackson, Mississippi 39201

WATER WELL DRILLERS LOG

8-12 1969 BRY Nicholson Newton
date well completed firm name county well located

LANDOWNER: Woodrow Lewis
Union
Miss.
(mailing address)

description of formations encountered	from	to
Clay & sand	0	30
blue dirt	30	95
blue dirt & sand	95	115
Sand Bad water	115	125
blue dirt	125	147
blue dirt & shell	147	168
rock	168	170
Green sand	170	195

WELL LOCATION:
sec. 2 T. 8 N R. 10 E
S W
17 miles West Union
(distance) (direction) (nearest town)

WELL PURPOSE: home
(home, irrigation, municipal, industrial)

WELL COMPLETION DATA:

- (1) diameter (inches) 4 1/4
- (2) total depth (feet) 195
- (3) static water level (feet) 70 below above top of ground.
- (4) casing galv. p. 147'
(material) (depth)
2"
(size) if telescope see back.
- (5) screen ✓
(length) (depth to top)
(size) (material)
- (6) pump 1 8
(HP) (yield gpm)
elect
(type power)
- (7) electric log _____
(yes or no)
(organization running log)
- (8) how well bottom plugged open


SFP - 3

MISS. BD. OF WATER COM.

DRILLERS REMARKS:

If well telescopes please sketch and show depths.

GROUND LEVEL

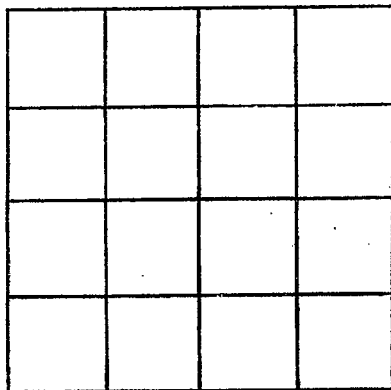

SECTION 2

Please indicate well location X.

ADDITIONAL INFORMATION

Lined area for writing additional information.

If more than one screen, show locations of each on sketch.