

Newton
A 25
3-11-70

MISSISSIPPI
 BOARD OF WATER COMMISSIONERS
 416 North State Street
 Jackson, Mississippi 39201

WATER WELL DRILLERS LOG

3-11-70 19 McDonald & Hill Newton
 date well completed firm name county well located

LANDOWNER: Robert Vance
Conehatta, Miss
 (mailing address)
 WELL LOCATION:
 sec. 31 T. 2 S. R. 10 E
4 miles N West of Conehatta
 (distance) (direction) (nearest town)

description of formations encountered	from	to
<u>Clay</u>	<u>0</u>	<u>22</u>
<u>Shale</u>	<u>22</u>	<u>78</u>
<u>Sand</u>	<u>78</u>	<u>200</u>
<u>Sandy</u>	<u>200</u>	<u>250</u>
<u>Shale</u>	<u>250</u>	<u>330</u>
<u>Sand</u>	<u>330</u>	<u>350</u>

WELL PURPOSE: None
 (home, irrigation, municipal, industrial)

WELL COMPLETION DATA:
 (1) diameter (inches) 4"
 (2) total depth (feet) 350
 (3) static water level (feet) 170' below top of ground.
 (4) casing Black, 273'
 (material) (depth)
4"
 (size) if telescope see back.
 (5) screen
 (length) (depth to top)

 (size) (material)
 (6) pump 1 10
 (HP) (yield gpm)
220
 (type power)
 (7) electric log NO
 (yes or no)
NO
 (organization running log)
 (8) how well bottom plugged OPEN


MAY 6 1970

MISS. DE. OF
 WATER RESOURCES

DRILLERS REMARKS:

If well telescopes please sketch and show depths.

GROUND LEVEL

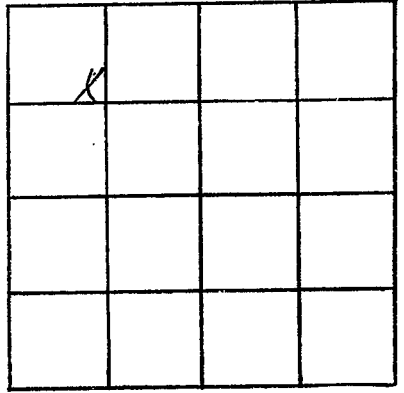

SECTION _____

Please indicate well location X.

ADDITIONAL INFORMATION

If more than one screen, show locations of each on sketch.