

NEWTON
A27
12-7-70

MISSISSIPPI
BOARD OF WATER COMMISSIONERS
416 North State Street
Jackson, Mississippi 39201

CODED

WATER WELL DRILLERS LOG

12-7-70 date well completed
RBT Nicholson firm name
Newton county well located

LANDOWNER: Louis Brumby
Union
Miss. (mailing address)

description of formations encountered	from	to
Dirt & Chalk	1	25
blue dirt	25	80
Shell	80	95
blue dirt	95	150
water sand	150	170

WELL LOCATION:
sec. 12 T. 8 N. R. 10 E
7 miles West of Union
(distance) (direction) (nearest town)

WELL PURPOSE: home
(home, irrigation, municipal, industrial)

- WELL COMPLETION DATA:
- (1) diameter (inches) 4 1/4
 - (2) total depth (feet) 170
 - (3) static water level (feet) 20 below top of ground.
 - (4) casing Galv. 165 (material) (depth)
2" (size) if telescope see back.
 - (5) screen 5' 170 (length) (depth to top)
1/4" Steel (size) (material)
 - (6) pump 1 12 (HP) (yield gpm)
Electric (type power)
 - (7) electric log No (yes or no)

CODED

(organization running log)

(8) how well bottom plugged Screen


MAY 3 - 1971

DRILLERS REMARKS:

MISS. BD. OF
WATER COMM.

If well telescopes please sketch and show depths.

GROUND LEVEL

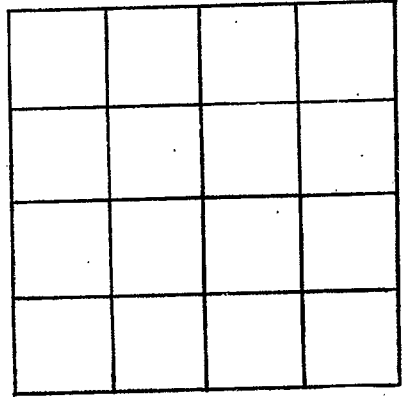

SECTION _____

Please indicate well location X.

ADDITIONAL INFORMATION

If more than one screen, show locations of each on sketch.