

Newton  
A28

9-6-71

MISSISSIPPI  
BOARD OF WATER COMMISSIONERS  
416 North State Street  
Jackson, Mississippi 39201

**CODED**

WATER WELL DRILLERS LOG

9-6

date well completed

1971

1971 *Corning Drilling Service* Newton


firm name

county well located

LANDOWNER: <i>Oscar Tatum</i>	description of formations encountered	from	to
<i>Corinthia R#1 Mine</i> (mailing address)	<i>Clay</i>	<i>5</i>	<i>70</i>
WELL LOCATION: sec. <i>15</i> T <i>8</i> N R <i>10</i> E <i>5</i> miles <i>SE</i> of <i>Sebastopol</i> (distance) (direction) (nearest town)	<i>Sand &amp; Clay</i>	<i>70</i>	<i>135</i>
WELL PURPOSE: <i>Home</i> (home, irrigation, municipal, industrial)	<i>Clay</i> <i>Sand</i>	<i>135</i>	<i>210</i> <i>216</i>
WELL COMPLETION DATA:	<i>Clay</i>	<i>255</i>	<i>300</i>
(1) diameter (inches) <i>2 1/2</i>	<i>Sand &amp; Shell</i>	<i>300</i>	<i>315</i>
(2) total depth (feet) <i>325</i>	<i>Sand</i>	<i>315</i>	<i>325</i>
(3) static water level (feet) <i>140</i> below top of ground.	<b>CODED</b>		
(4) casing <i>Steel</i> , <i>293</i> (material), (depth)			
(5) screen (size) if telescope see back.	<b>CODED</b>		
(6) pump <i>1 1/2</i> (HP), <i>3</i> (yield gpm)			
(7) electric log <i>No</i> (yes or no)	<b>CODED</b>		
(8) how well bottom plugged <i>(circle)</i>			
DRILLERS REMARKS:	APR 12 1971		

If well telescopes please  
sketch and show depths.

GROUND LEVEL

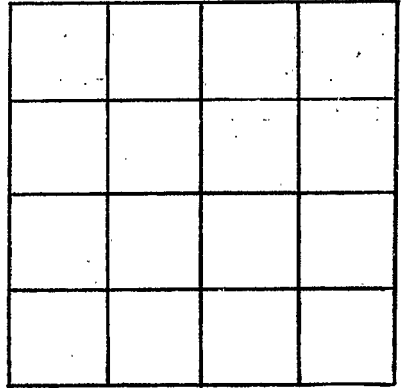

SECTION \_\_\_\_\_

Please indicate well location X.

ADDITIONAL INFORMATION

If more than one screen,  
show locations of each on sketch.