

NEWTON
A 32
8-26-75

MISSISSIPPI
BOARD OF WATER COMMISSIONERS
416 North State Street
Jackson, Mississippi 39201

WATER WELL DRILLERS LOG

8-26-1975 date well completed
Common Drilling Service firm name
Newton county well located

LANDOWNER: Larry French
Picture Rt 1 Minn
(mailing address)
WELL LOCATION:
sec. 24 T 8 N R 10 E S 5
10 miles S.E. of Scottdale
(distance) (direction) (nearest town)

WELL PURPOSE: Home
(home, irrigation, municipal, industrial)

- WELL COMPLETION DATA:
- (1) diameter (inches) 4"
 - (2) total depth (feet) 305
 - (3) static water level (feet) 95 below above top of ground.
 - (4) casing PVC, 233 (material) (depth) (size) if telescope see back.
 - (5) screen Mono (length) (depth to top) (size) (material)
 - (6) pump 3/4 HP 10 (HP) (yield gpm) Electric (type power)
 - (7) electric log Mono (yes or no) (organization running log)
 - (8) how well bottom plugged


description of formations encountered	from	to
Clay	0	68
Sand & Clay	68	110
Sand	110	155
Clay	155	209
Sand & Clay	209	238
Clay	238	290
Sand	290	305

MISSISSIPPI BOARD OF WATER COMMISSIONERS
OCT 15 1975
MISS. BO. OF WATER COMM.

DRILLERS REMARKS:

If well telescopes please sketch and show depths.

GROUND LEVEL

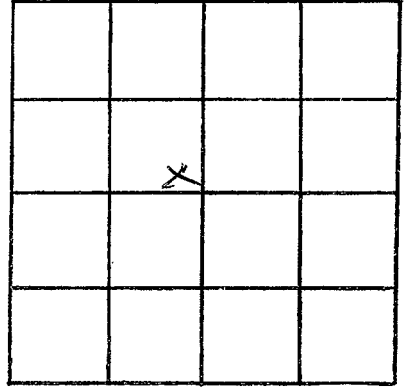

SECTION _____

Please indicate well location X.

ADDITIONAL INFORMATION

If more than one screen, show locations of each on sketch.