

MISSISSIPPI DEPARTMENT OF NATURAL RESOURCES

Bureau of Land and Water Resources

Southport Mall

P.O. Box 10631

Jackson, Mississippi 39209

WATER WELL DRILLERS LOG

CODED

Newton  
A34  
6-4-85

GW-2904

6-4-85 date well completed  
19 Gordon Water Supply, Inc. firm name  
Newton county well located

LANDOWNER: Schotopae  
Water Association  
Schotopae, Miss.  
(mailing address)

WELL LOCATION:  
sec. 6 T. 8 N. R. 10 E.  
S. W.  
2 miles SE of Schotopae  
(distance) (direction) (nearest town)

WELL PURPOSE:  
(home, irrigation, municipal, industrial)

WELL COMPLETION DATA:

(1) diameter (inches) 12  
(2) total depth (feet) 325  
(3) static water level (feet) 90 below top of ground.  
(4) casing Steel 497  
(material) (depth)  
(size) if telescope see back.  
(5) screen 30" 475'  
(length) (depth to top)  
8 88  
(size) (material)  
(6) pump 50 465  
(HP) (yield gpm)  
Electric  
(type power)  
(7) electric log yes  
(yes or no)  
Gordon Water Supply, Inc.  
(organization running log)  
(8) how well bottom plugged Backwash  
valve

description of formations encountered	from	to
Brown Clay	0	8
White Sand	8	75
Grey Shales	75	185
Shale, (4' lbs) Rock	185	190
Sand	190	215
Rock & Shale	215	340
Silt Sand	340	350
Fine Sand	350	490
Coarse Sand	490	540
Sandy Shale	540	630
Shale	630	705
Sandy Shale	705	717
Hard Rock	717	718
Sandy Shale	718	768
Hard Rock	768	770
Sandy Shale	770	783
Rock	783	

RECEIVED


JUN 13 1985

Department of Natural Resources  
Bureau of Land & Water Resources

DRILLERS REMARKS:

If well telescopes please sketch and show depths.

GROUND LEVEL

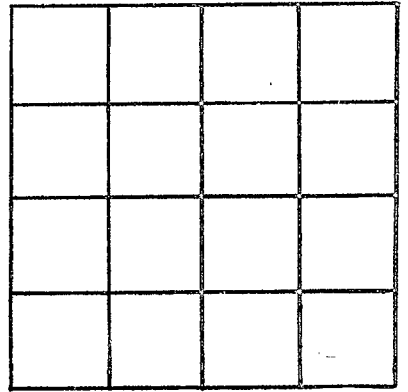

SECTION \_\_\_\_\_

Please indicate well location X.

ADDITIONAL INFORMATION

If more than one screen,  
show locations of each on sketch.