

Newton  
 A 2001  
 8-23-76

MISSISSIPPI  
 BOARD OF WATER COMMISSIONERS  
 416 North State Street  
 Jackson, Mississippi 39201

WATER WELL DRILLERS LOG

8, 23, 76 <sup>137</sup> McDonald + Hill NEWTON  
 date well completed firm name county well located

LANDOWNER:	description of formations encountered	from	to
Billy Thomas			
RA 2 UNION 7 (mailing address)	shale	26	40
WELL LOCATION: sec 26 T 68 N R 15 E 10 4 miles WEST STRATTON (distance) (direction) (nearest town)	sand	40	90
WELL PURPOSE: (home, irrigation, municipal, industrial)	sand	90	126
WELL COMPLETION DATA: (1) diameter (inches) 4" (2) total depth (feet) 230 (3) static water level (feet) 50' below top of ground. (4) casing PVC 162' (material) (depth) 4" (size) if telescope see back. (5) screen (length) (depth to top) (size) (material) (6) pump 2 sub 10 (HP) (yield gpm) E (type power) (7) electric log (yes or no) (organization running log) (8) how well bottom plugged OPEN	soft shale	126	140
	shale	140	172
	Rock shale	172	190
	sand	190	230
DRILLERS REMARKS:			


RECEIVED

AUG 26 1976

MISS. BD. OF WATER COMMISSIONERS

If well telescopes please sketch and show depths.

GROUND LEVEL

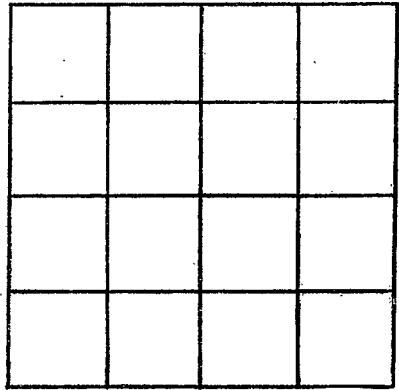

SECTION \_\_\_\_\_

Please indicate well location X.

ADDITIONAL INFORMATION

If more than one screen, show locations of each on sketch.