

NEWTON  
A 2002  
2-2-77

MISSISSIPPI  
 BOARD OF WATER COMMISSIONERS  
 416 North State Street  
 137 Jackson, Mississippi 39201

WATER WELL DRILLERS LOG

2-2-77 19 McDonald & Hill Newton  
 date well completed firm name county well located


LANDOWNER:	description of formations encountered	from	to
<u>Cyell Williams</u>	<u>clay &amp; sand</u>	<u>0</u>	<u>80</u>
<u>Rt #1 Decatur</u> (mailing address)	<u>sand &amp; shale</u>	<u>80</u>	<u>150</u>
WELL LOCATION: sec. <u>26</u> T. <u>8</u> N. R. <u>10</u> E <u>84±</u> miles <u>NE</u> of <u>Comalata</u> (distance) (direction) (nearest town)	<u>sandy shale</u>	<u>150</u>	<u>190</u>
	<u>shale</u>	<u>190</u>	<u>220</u>
	<u>Rock &amp; shells</u>	<u>220</u>	<u>245</u>
WELL PURPOSE: <u>home</u> (home, irrigation, municipal, industrial)	<u>green sand</u>	<u>245</u>	<u>280</u>
WELL COMPLETION DATA:			
(1) diameter (inches) <u>4"</u>			
(2) total depth (feet) <u>280'</u>			
(3) static water level (feet) <u>90'</u> below top of ground.			
(4) casing <u>PVC</u> , <u>210'</u> (material) (depth) <u>4"</u> (size) if telescope see back.			
(5) screen _____ (length) (depth to top) _____ (size) (material)			
(6) pump <u>1/2</u> <u>590</u> (HP) (yield gpm) <u>E</u> (type power)			
(7) electric log _____ (yes or no) _____ (organization running log)			
(8) how well bottom plugged <u>open</u>			
DRILLERS REMARKS:			

**RECEIVED**  
 FEB - 8 1977

MISS. RD. OF WATER COMM

If well telescopes please  
sketch and show depths.

GROUND LEVEL

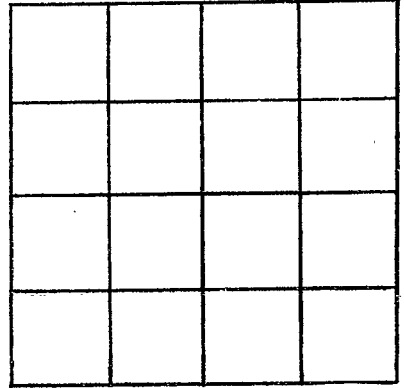

SECTION \_\_\_\_\_

Please indicate well location X.

ADDITIONAL INFORMATION

If more than one screen,  
show locations of each on sketch.