

**NEWTON**  
**A 2003**  
**5-12-77**

MISSISSIPPI  
 BOARD OF WATER COMMISSIONERS  
 416 North State Street  
 Jackson, Mississippi 39201

137

**WATER WELL DRILLERS LOG**

5-12-77 19 McDonald & Hill Newton  
 date well completed firm name county well located

**LANDOWNER:**

Frank McLaugh  
Rt #1 Decatur  
 (mailing address)

**description of formations encountered**

from to

|                        |     |     |
|------------------------|-----|-----|
| clay & sand            | 8   | 55  |
| sand & shale           | 55  | 152 |
| sandy shale & str rock | 152 | 178 |
| Rock                   | 178 | 179 |
| sandy shale            | 179 | 195 |
| shale                  | 195 | 230 |
| Rock & sh. bls         | 230 | 252 |
| green sand             | 252 | 280 |

**WELL LOCATION:**

sec 35 T 8 N 5 R 10 E W  
8 miles NE of Conhatta  
 (distance) (direction) (nearest town)

**WELL PURPOSE:** home  
 (home, irrigation, municipal, industrial)

**WELL COMPLETION DATA:**


- (1) diameter (inches) 4 1/2"
- (2) total depth (feet) 280'
- (3) static water level (feet) 105' below above top of ground.
- (4) casing PVC, 2 1/2" (material) (depth)  
4 1/2" if telescope see back. (size)
- (5) screen \_\_\_\_\_ (length) \_\_\_\_\_ (depth to top)  
 \_\_\_\_\_ (size) \_\_\_\_\_ (material)
- (6) pump 1/2 50 gpm (HP) (yield gpm)  
E (type power)
- (7) electric log \_\_\_\_\_ (yes or no)  
 \_\_\_\_\_ (organization running log)
- (8) how well bottom plugged 90%

**DRILLERS REMARKS:**

**RECEIVED**  
 MAY 23 1977  
 MISS. BD. OF WATER COMMISSIONERS

If well telescopes please sketch and show depths.

GROUND LEVEL

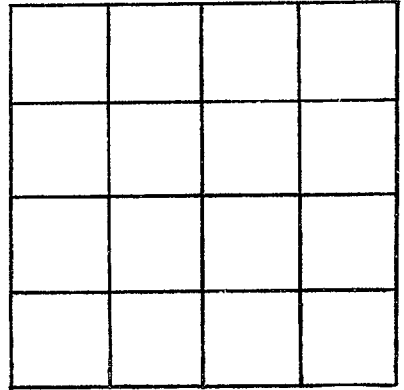

SECTION \_\_\_\_\_

Please indicate well location X.

ADDITIONAL INFORMATION

If more than one screen,  
show locations of each on sketch.