

Newton

A 2004

5-13-77

MISSISSIPPI  
 BOARD OF WATER COMMISSIONERS  
 416 North State Street  
 Jackson, Mississippi 39201

WATER WELL DRILLERS LOG

5-13-77 date well completed  
 McDonald & Hill firm name  
 Newton county well located


LANDOWNER:	description of formations encountered	from	to
Robert Vance	Clay & sand	0	15
RT# Conehatta (mailing address)	shale	15	60
WELL LOCATION:	sandy	60	70
sec. 33 T. 8 N. R. 12 E	shale & sand +	70	115
4 miles N of Conehatta (distance) (direction) (nearest town)	lignite sand	115	210
WELL PURPOSE: home (home, irrigation, municipal, industrial)	sandy shale	210	255
WELL COMPLETION DATA:	shale	255	300
(1) diameter (inches) 4"	Rock & shale	300	325
(2) total depth (feet) 400'	sand & sandy shale	325	360
(3) static water level (feet) 165' below top of ground.	Rock & shale	360	390
(4) casing PVC, 280' (material) (depth)	sand	390	400
4" if telescope see back. (size)			
(5) screen (length) (depth to top)			
(size) (material)			
(6) pump 3/4 HP, 600 gpm (HP) (yield gpm)			
K (type power)			
(7) electric log (yes or no)			
(organization running log)			
(8) how well bottom plugged open			
DRILLERS REMARKS:			

**RECEIVED**  
 MAY 23 1977

MISS. BD. OF WATER COMMISSIONERS

If well telescopes please sketch and show depths.

GROUND LEVEL

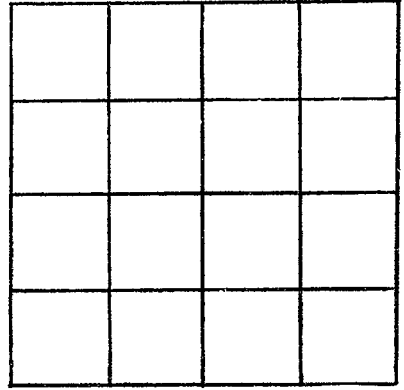

SECTION \_\_\_\_\_

Please indicate well location X.

ADDITIONAL INFORMATION

If more than one screen,  
show locations of each on sketch.