

NEWTON
A 2006
9-15-77

MISSISSIPPI
 BOARD OF WATER COMMISSIONERS
 416 North State Street
 137 Jackson, Mississippi 39201

WATER WELL DRILLERS LOG

9-15-77 19 McDonald & Hill Newton
 date well completed firm name county well located


LANDOWNER:	description of formations encountered	from	to
<u>Randall Jones</u> <u>Rt # 2 Union</u> (mailing address)			
WELL LOCATION: sec. <u>5</u> T. <u>8</u> N. R. <u>14</u> E <u>10</u> miles <u>W</u> of <u>Union</u> (distance) (direction) (nearest town)	<u>sandy shale</u>	<u>48</u>	<u>60</u>
WELL PURPOSE: <u>home</u> (home, irrigation, municipal, industrial)	<u>shale</u>	<u>60</u>	<u>113</u>
WELL COMPLETION DATA: (1) diameter (inches) <u>4"</u> (2) total depth (feet) <u>180</u> (3) static water level (feet) <u>18'</u> below top of ground. (4) casing <u>PVC</u> <u>105'</u> (material) (depth) <u>4"</u> (size) if telescope see back. (5) screen _____ (length) (depth to top) _____ (size) (material) (6) pump <u>1/2</u> <u>50.0M</u> (HP) (yield gpm) <u>E</u> (type power) (7) electric log _____ (yes or no) _____ (organization running log) (8) how well bottom plugged <u>open</u>	<u>Rock + shells</u>	<u>113</u>	<u>141</u>
	<u>green sandy sandy shale</u>	<u>141</u>	<u>150</u>
	<u>Rock + shale</u>	<u>150</u>	<u>160</u>
	<u>sand st rock</u>	<u>160</u>	<u>190</u>
DRILLERS REMARKS:			

RECEIVED
 SEP 19 1977

MISS. BD. OF WATER COMM

If well telescopes please sketch and show depths.

GROUND LEVEL

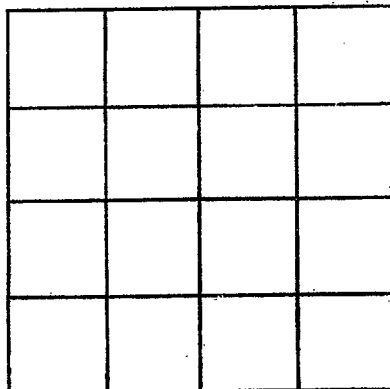

SECTION _____

Please indicate well location X.

ADDITIONAL INFORMATION

If more than one screen, show locations of each on sketch.