

Newton
A 2007
11/16/77

MISSISSIPPI
BOARD OF WATER COMMISSIONERS
416 North State Street
Jackson, Mississippi 39201

WATER WELL DRILLERS LOG


11-16-77 date well completed
McDonald & Hill firm name
Newton county well located

LANDOWNER:	description of formations encountered	from	to
Billy W. Sluerton Rt #2 Union (mailing address)			
WELL LOCATION:	sandy shale	45	60
sec. <u>1</u> T <u>8</u> N <u>5</u> R <u>D</u> E <u>W</u>	shale	60	120
<u>10</u> miles <u>W</u> of <u>Union</u>	Rock & shells	120	145
(distance) (direction) (nearest town)	green sand & sandy shale	145	155
WELL PURPOSE: <u>none</u>	Sand & Rock	155	180
(home, irrigation, municipal, industrial)			
WELL COMPLETION DATA:			
(1) diameter (inches) <u>4"</u>			
(2) total depth (feet) <u>180'</u>			
(3) static water level (feet) <u>17'</u> below top of ground.			
(4) casing <u>PVC</u> <u>110'</u>			
(material) (depth)			
<u>4"</u> if telescope see back.			
(size)			
(5) screen _____			
(length) (depth to top)			
(size) (material)			
(6) pump <u>3/4</u> <u>600M</u>			
(HP) (yield gpm)			
<u>E</u>			
(type power)			
(7) electric log _____			
(yes or no)			
(organization running log)			
(8) how well bottom plugged <u>Open</u>			
DRILLERS REMARKS:			

RECEIVED
NOV 22 1977
OF WATER COMMISSIONERS

If well telescopes please sketch and show depths.

GROUND LEVEL

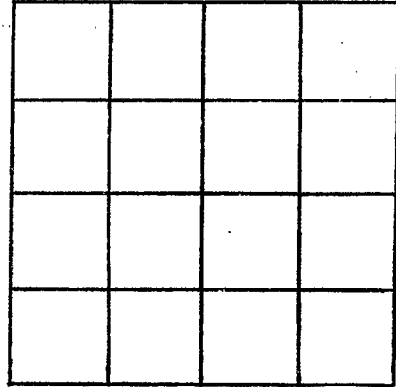

SECTION _____

Please indicate well location X.

ADDITIONAL INFORMATION

If more than one screen, show locations of each on sketch.