

Newton
 A 2009
 12/20/77

MISSISSIPPI
 BOARD OF WATER COMMISSIONERS
 416 North State Street
 Jackson, Mississippi 39201

WATER WELL DRILLERS LOG

12-20-77, 19 McDonalds Well Newton
 date well completed firm name county well located

LANDOWNER: Choctaw Utility
Dillon Smith, Job
Box # 1, Conehatta
 (mailing address):

| description of formations encountered | from | to |
|---------------------------------------|------|-----|
| clay | 0 | 20 |
| clay + sand | 20 | 30 |
| shale | 30 | 40 |
| sandy shale | 40 | 72 |
| sand + st shale | 72 | 100 |

WELL LOCATION:
 sec. 33 T. 8 N. R. 10 E
4 miles N of Conehatta
 (distance) (direction) (nearest town)

| | | |
|-----------------|-----|-----|
| shale + lignite | 100 | 160 |
|-----------------|-----|-----|

WELL PURPOSE: home
 (home, irrigation, municipal, industrial)

| | | |
|------|-----|-----|
| sand | 160 | 260 |
|------|-----|-----|

WELL COMPLETION DATA:

- (1) diameter (inches) 4"
- (2) total depth (feet) 380'
- (3) static water level (feet) 135' below top of ground.
- (4) casing PVC 305'
 (material) (depth)
4" if telescope see back.
 (size)
- (5) screen _____
 (length) (depth to top)
 (size) (material)
- (6) pump 3/1 69.0M
 (HP) (x' of d gpm)
- E
 (type power)
- (7) electric log _____
 (yes or no)
 (organization running log)
- (8) how well bottom plugged open

| | | |
|---------------|-----|-----|
| sandy shale | 260 | 295 |
| shale | 295 | 330 |
| Rock + shells | 330 | 365 |
| green sand | 365 | 380 |


RECEIVED
 DEC 27 1977

MISS. DEPT. OF WATER & COMMERCE

DRILLERS REMARKS:

If well telescopes please sketch and show depths.

GROUND LEVEL

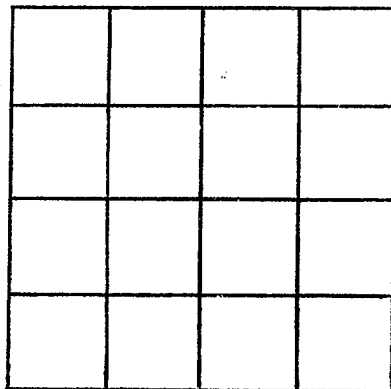

SECTION _____

Please indicate well location X.

ADDITIONAL INFORMATION

If more than one screen, show locations of each on sketch.