

Newton
A 2010
2/2/78

MISSISSIPPI
BOARD OF WATER COMMISSIONERS
416 North State Street
Jackson, Mississippi 39201

WATER WELL DRILLERS LOG

2-278 19 McDonald's Hill Newton
date well completed firm name county well located

LANDOWNER:
Carroll Reed
Rt # 2 Union
(mailing address)

WELL LOCATION:
sec. 13 T. 8 N. R. 120 E.
10 miles SW of Union
(distance) (direction) (nearest town)

WELL PURPOSE: home
(home, irrigation, municipal, industrial)

- WELL COMPLETION DATA:
- (1) diameter (inches) 4"
 - (2) total depth (feet) 260'
 - (3) static water level (feet) 115' below top of ground
 - (4) casing PVC 192'
(material) (depth)
4" if telescope see back.
(size)
 - (5) screen _____
(length) (depth to top)
(size) (material)
 - (6) pump 1/2 600
(HP) (yield gpm)
E
(type power)
 - (7) electric log _____
(yes or no)

(organization running log)
 - (8) how well bottom plugged open

description of formations encountered	from	to
clay	0	8
shale	8	20
clay + sand	20	30
shale + sand	30	50
sand	50	180
sandy shale	120	160
shale + sand	160	185
shale	185	205
rock + shells	205	225
green sand	225	240
rock + shale	240	250
sand	250	260


RECEIVED
MAR - 6 1978

DRILLERS REMARKS:

MISS. BD. OF WATER COMM

If well telescopes please sketch and show depths.

GROUND LEVEL

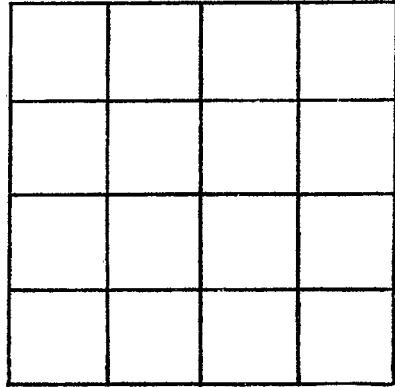

SECTION _____

Please indicate well location X.

ADDITIONAL INFORMATION

If more than one screen,
show locations of each on sketch.