

NEWTON
 A 2013
 8-30-78

MISSISSIPPI
 BOARD OF WATER COMMISSIONERS
 416 North State Street
 Jackson, Mississippi 39201

WATER WELL DRILLERS LOG

8-30-78 date well completed
 McDonald Well firm name
 Newton county well located

LANDOWNER:	description of formations encountered	from	to
Royce Mullins	clay	0	12
Rt # 1 Decatur (mailing address)	sand st clay	12	45
WELL LOCATION: sec. 32 T 8 N R 14 E 10? 4 miles N of Conhatta (distance) (direction) (nearest town)	sand st shales & lignite	45	130
	sandy shale	130	175
	shale	175	215
WELL PURPOSE: home (home, irrigation, municipal, industrial)	rock & shells	215	230
WELL COMPLETION DATA:	open sand & sandy shale	230	245
(1) diameter (inches) 4"	rock & shale	245	270
(2) total depth (feet) 280	sand	270	280
(3) static water level (feet) 115' below top of ground.			
(4) casing PVC 190' (material) (depth)			
4" if telescope see back. (size)			
(5) screen (length) (depth to top)			
(size) (material)			
(6) pump 3/4 60 gpm (HP) (field gpm)			
(type power) E			
(7) electric log (yes or no)			
(organization running log)			
(8) how well bottom plugged open			


RECEIVED
 SEP 11 1978

MISS. Bd. OF WATER COMM.

DRILLERS REMARKS:

If well telescopes please sketch and show depths.

GROUND LEVEL

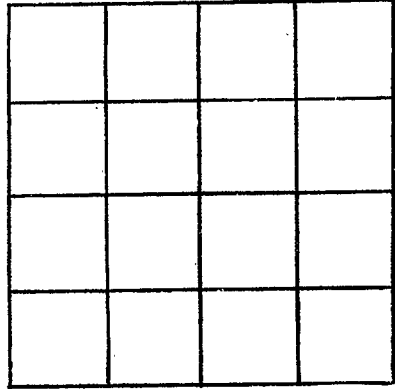

SECTION _____

Please indicate well location X.

ADDITIONAL INFORMATION

If more than one screen,
show locations of each on sketch.