

NEWTON

A 2014

8/08/79

MISSISSIPPI BOARD OF WATER COMMISSIONERS
416 North State Street
Jackson, Mississippi 39201

WATER WELL DRILLERS LOG

8-8-79
date well completed

McDonald & Hill
firm name

Newton
county well located

LANDOWNER:

Debra Leach

Rt # 2 Union
(mailing address)

description of formations encountered

Clay & sand

from

to

0 16

sand

16 35

shale & lignite

35 65

sand

65 120

sandy shale

120 160

shale

160 202

WELL LOCATION:

sec. 24 T 8 N R 10 E
8 miles SW of Union
(distance) (direction) (nearest town)

WELL PURPOSE: home
(home, irrigation, municipal, industrial)

WELL COMPLETION DATA:

(1) diameter (inches) 4"

(2) total depth (feet) 260'

(3) static water level (feet) 95' below top of ground.

(4) casing PVC 140'
(material) (depth)

4" if telescope see back.
(size)

(5) screen
(length) (depth to top)

(size) (material)

(6) pump 1/2 10 gpm
(HP) (yield/gpm)

(type power)

(7) electric log
(yes or no)

(organization running log)

(8) how well bottom plugged open

Rock & shells 902 225

green sand 925 240

sand & Rock & shell 240 260

Miss. Board of Water Comm.


AUG 14 1979

DRILLERS REMARKS:

RECEIVED

If well telescopes please sketch and show depths.

GROUND LEVEL

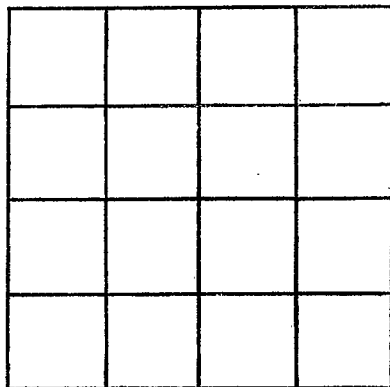

SECTION _____

Please indicate well location X.

ADDITIONAL INFORMATION

If more than one screen,
show locations of each on sketch.