

NEWTON

MISSISSIPPI
BOARD OF WATER COMMISSIONERS
416 North State Street
Jackson, Mississippi 39201

A-2015

3-3-80

3-3-80

date well completed

WATER WELL DRILLERS LOG

McDonald & Hill Newton

firm name

county well located

LANDOWNER:	description of formations encountered	from	to
Perry Lee Branch	clay & sand	0	15
Rt # 1 Conehatta (mailing address)	sandy shale	15	60
WELL LOCATION:	sandy shale	60	100
sec. <u>23</u> T <u>8</u> N R <u>12</u> E	sand	100	215
<u>8</u> miles <u>NE</u> of <u>Conehatta</u>	sandy shale	215	245
(distance) (direction) (nearest town)	shale	245	290
WELL PURPOSE: <u>home</u> (home, irrigation, municipal, industrial)	Rock & shells	290	315
WELL COMPLETION DATA:	green sand	315	330
(1) diameter (inches) <u>4"</u>	white sand	330	340
(2) total depth (feet) <u>340'</u>			
(3) static water level (feet) <u>150'</u> below above top of ground.			
(4) casing <u>PVC</u> <u>260'</u> (material) (depth)			
<u>4"</u> (size) if telescope see back.			
(5) screen _____ (length) (depth to top)			
(size) (material)			
(6) pump <u>3/4</u> <u>600m</u> (HP) (yld gpm)			
<u>E</u> (type power)			
(7) electric log _____ (yes or no)			
(organization running log)			
(8) how well bottom plugged <u>Open</u>			
DRILLERS REMARKS:			


DEPT. OF LAND & WATER RESOURCES
MISSISSIPPI

MAR 11 1981

RECEIVED

If well telescopes please sketch and show depths.

GROUND LEVEL

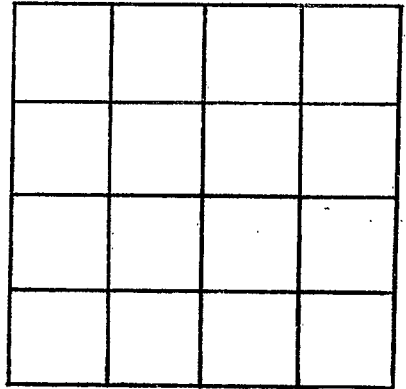

SECTION _____

Please indicate well location X.

ADDITIONAL INFORMATION

If more than one screen,
show locations of each on sketch.