

Newton
A 216
4-14-80

MISSISSIPPI
BOARD OF WATER COMMISSIONERS
416 North State Street
Jackson, Mississippi 39201

WATER WELL DRILLERS LOG

4-14-80 date well completed
McDonald & Hill firm name
Newton county well located

LANDOWNER:	description of formations encountered	from	to
J.C. Lopez	clay	0	25
Rt #2 Union (mailing address)	shale	25	40
WELL LOCATION:	sand	40	70
sec. 24 T8 N R 10 E	shale	70	90
12 miles SW of Union (distance) (direction) (nearest town)	sand	90	150
WELL PURPOSE: home (home, irrigation, municipal, industrial)	sandy shale	150	190
WELL COMPLETION DATA:	shale	190	228
(1) diameter (inches) 4"	Rock & shells	228	250
(2) total depth (feet) 280'	green sand & sandy shale	250	270
(3) static water level (feet) 180' below top of ground.	white sandy shale	270	280
(4) casing PVC 305' (material) (depth) 4" if telescope see back. (size)			
(5) screen (length) (depth to top) (size) (material)			
(6) pump 1/2 8gpm (HP) (yield gpm) (type power)			
(7) electric log (yes or no) (organization running log)			
(8) how well bottom plugged open			
DRILLERS REMARKS:			


DEPT. OF NATURAL RESOURCES
BUREAU OF LAND & WATER RESOURCES

APR 23 1980

RECEIVED

If well telescopes please sketch and show depths.

GROUND LEVEL

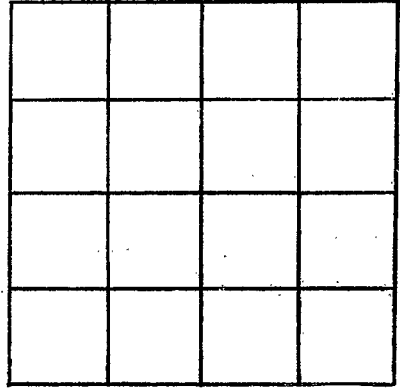

SECTION _____

Please indicate well location X.

ADDITIONAL INFORMATION

If more than one screen, show locations of each on sketch.