

MISSISSIPPI DEPARTMENT OF NATURAL RESOURCES

Bureau of Land and Water Resources

Southport Mall

P.O. Box 10631

Jackson, Mississippi 39209

WATER WELL DRILLERS LOG

NEWTON
A 2018
9-23-80

9-23-80, McDonald & Hill Newton
 date well completed firm name county well located

LANDOWNER:
Frank C. Ricketts
R.O. Box 99 Union
 (mailing address)

WELL LOCATION:
 sec. 24 T. 8 N. R. 10 E.
6 miles SW of Union
 (distance) (direction) (nearest town)

WELL PURPOSE: none
 (home, irrigation, municipal, industrial)

WELL COMPLETION DATA:

(1) diameter (inches) 4"

(2) total depth (feet) 280'

(3) static water level (feet) 100' below above top of ground.

(4) casing PVC 190'
 (material) (depth)
4" if telescope see back.
 (size)

(5) screen _____
 (length) (depth to top)
 (size) (material)

(6) pump 1/2 600
 (HP) (yield gpm)
R
 (type power)

(7) electric log _____
 (yes or no)
 (organization running log)

(8) how well bottom plugged open

description of formations encountered	from	to
clay	0	12
sandy clay	12	60
shale & sand	60	85
sand	85	130
sandy shale	130	170
shale	170	220
rock & shell	220	245
green sand & sandy shale	245	262
sand & rock & shale	262	280

DEPT. OF NATURAL RESOURCES
 BUREAU OF LAND & WATER RESOURCES


SEP 29 1980

RECEIVED

DRILLERS REMARKS:

If well telescopes please sketch and show depths.

GROUND LEVEL

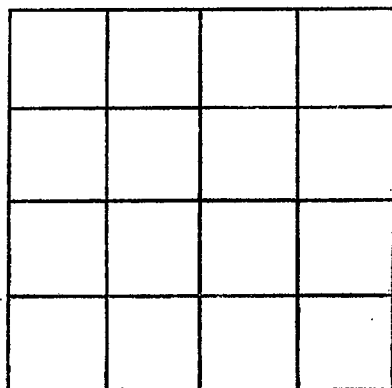

SECTION _____

Please indicate well location X.

ADDITIONAL INFORMATION

If more than one screen,
show locations of each on sketch.