

NEWTON  
A 2019  
3-4-81

MISSISSIPPI  
BOARD OF WATER COMMISSIONERS  
416 North State Street  
Jackson, Mississippi 39201




WATER WELL DRILLERS LOG

3-4-81 19 McDonald & Hill Newton  
date well completed firm name county well located

LANDOWNER:	description of formations encountered	from	to
Jerry Vorse	clay & sand	0	20
Rt # 2 Union (mailing address)	shale	20	32
WELL LOCATION:	sand at shale & lignite	32	130
sec. 14 T 8 N R 10 E S W 8 miles W of Union (distance) (direction) (nearest town)	sandy shale	130	170
WELL PURPOSE: (home, irrigation, municipal, industrial)	shale	170	219
WELL COMPLETION DATA:	rocky shells	219	245
(1) diameter (inches) 4	green sand	245	260
(2) total depth (feet) 260			
(3) static water level (feet) 100' below top of ground.			
(4) casing PVC 200' (material) (depth) 4" (size) if telescope see back.			
(5) screen (length) (depth to top) (size) (material)			
(6) pump 1/2 8gpm (HP) (yield gpm) F (type power)			
(7) electric log (yes or no) (organization running log)			
(8) how well bottom plugged			

DEPT. OF NATURAL RESOURCES  
BUREAU OF LAND & WATER RESOURCES


MAR 20 1981

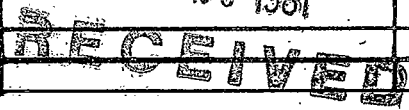

DRILLERS REMARKS:

If well telescopes please sketch and show depths.

GROUND LEVEL

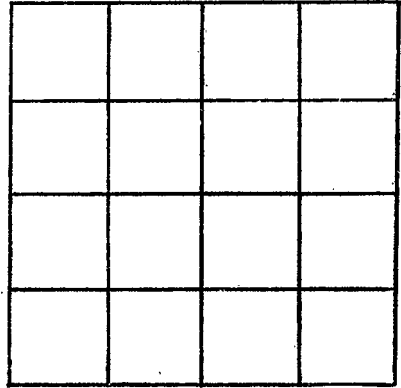

SECTION \_\_\_\_\_

Please indicate well location X.

ADDITIONAL INFORMATION

If more than one screen, show locations of each on sketch.