

MISSISSIPPI DEPARTMENT OF NATURAL RESOURCES

Bureau of Land and Water Resources

Southport Mall

P.O. Box 10631

Jackson, Mississippi 39209

WATER WELL DRILLERS LOG

Newton
A 2000
4-16-81

4-16-81 19 McDonald & Hill Newton
 date well completed firm name county well located

LANDOWNER:	description of formations encountered	from	to
<u>Davis French</u> <u>Rt #1 Decatur</u> (mailing address)			
<u>WELL LOCATION:</u> sec. <u>26</u> T <u>8</u> N R <u>10</u> E <u>10</u> miles <u>SW</u> of <u>Union</u> (distance) (direction) (nearest town)	<u>sandy shale</u>	<u>15</u>	<u>200</u>
<u>WELL PURPOSE:</u> <u>home</u> (home, irrigation, municipal, industrial)	<u>shale</u>	<u>200</u>	<u>240</u>
<u>WELL COMPLETION DATA:</u>	<u>rock & shells</u>	<u>240</u>	<u>265</u>
(1) diameter (inches) <u>4"</u>	<u>green sand</u>	<u>265</u>	<u>280</u>
(2) total depth (feet) <u>280</u>			
(3) static water level (feet) <u>95'</u> below above top of ground.			
(4) casing <u>PVC 200'</u> (material) (depth) <u>4"</u> if telescope see back. (size)			
(5) screen _____ (length) (depth to top) (size) (material)			
(6) pump <u>1/2</u> <u>8 gpd</u> (HP) (yield/gpm) <u>π</u> (type power)			
(7) electric log _____ (yes or no) (organization running log)			
(8) how well bottom plugged <u>OK</u>			

DRILLERS REMARKS:


DEPT. OF NATURAL RESOURCES
 BUREAU OF LAND & WATER RESOURCES

APR 28 1981

RECEIVED

If well telescopes please
sketch and show depths.

GROUND LEVEL

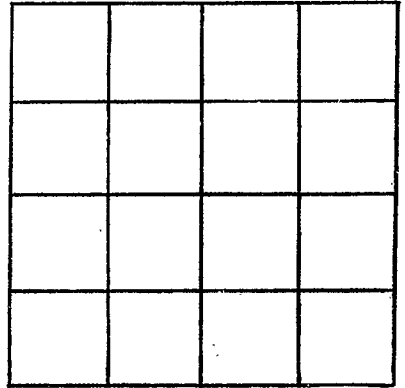

SECTION _____

Please indicate well location X.

ADDITIONAL INFORMATION

If more than one screen,
show locations of each on sketch.