

Newton  
A  
2023

MISSISSIPPI  
BOARD OF WATER COMMISSIONERS  
416 North State Street  
Jackson, Mississippi 39201

WATER WELL DRILLERS LOG

date well completed

firm name

county well located

19 81 Mc Donald Hill Newton

LANDOWNER: Carrie Shealy  
Rt # 1  
Newton, MS  
(mailing address)

WELL LOCATION:  
sec. 36 T. 4 N. R. 10 E.  
S  
10 miles west of Newton  
(distance) (direction) (nearest town)

WELL PURPOSE: Home  
(home, irrigation, municipal, industrial)

- WELL COMPLETION DATA:
- (1) diameter (inches) 4
  - (2) total depth (feet) 280
  - (3) static water level (feet) 93 below above top of ground.
  - (4) casing 4" PVC, 182'  
(material) (depth)  
(size) if telescope see back.
  - (5) screen 10, 270  
(length) (depth to top)  
(size) (material)
  - (6) pump 1, 12  
(HP) (yield gpm)  
(type power)
  - (7) electric log                       
(yes or no)  
(organization running log)
  - (8) how well bottom plugged opened


description of formations encountered	from	to
<u>clay + sand</u>	<u>0</u>	<u>50</u>
<u>shale + sand</u>	<u>50</u>	<u>90</u>
<u>shale</u>	<u>90</u>	<u>108</u>
<u>Red sand</u>	<u>108</u>	<u>140</u>
<u>sand</u>	<u>140</u>	<u>170</u>
<u>green sand st rock</u>	<u>170</u>	<u>180</u>
<u>shale</u>	<u>180</u>	<u>230</u>
<u>sand st green sand</u>	<u>230</u>	<u>270</u>
<u>course green sand</u>	<u>270</u>	<u>280</u>

DEPT. OF NATURAL RESOURCES  
BUREAU OF LAND & WATER RESOURCES  
JAN 12 1982  
RECEIVED

DRILLERS REMARKS:

If well telescopes please sketch and show depths.

GROUND LEVEL

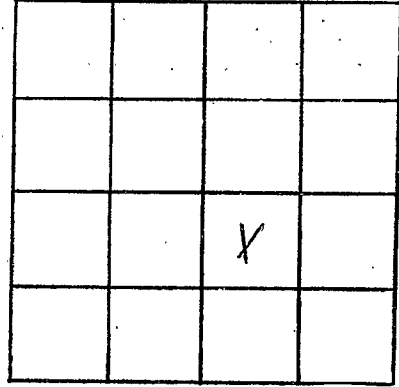

SECTION 36

Please indicate well location X.

ADDITIONAL INFORMATION

If more than one screen, show locations of each on sketch.